

PONTOTOC
B 2011

MISSISSIPPI
BOARD OF WATER COMMISSIONERS
416 North State Street
Jackson, Mississippi 39201

WATER WELL DRILLERS LOG

Sept 1986 Leeper Drilling Pontotoc
date well completed firm name county well located

LANDOWNER: JAMES HORTON

RT

ECRU MS

(mailing address)

WELL LOCATION:

sec 36 T 9 N R 2 E
S W
 $\frac{1}{2}$ miles SW of ECRU
(distance) (direction) (nearest town)

WELL PURPOSE:

(home, irrigation, municipal, industrial)

WELL COMPLETION DATA:

- (1) diameter (inches) 4"
- (2) total depth (feet) 180'
- (3) static water level (feet) 60 below above top of ground
- (4) casing PVC 50' (material) (depth)
4" (size) If telescope see back.
- (5) screen NONE (length) (depth to top)
(size) (material)
- (6) pump 1 10 (HP) (yield gpm)
ELEC (type power)
- (7) electric log N/D (yes or no)
- (organization running log)
- (8) how well bottom plugged OPEN

description of formations encountered

from to

TOP CLAY	0	10
RED SAND	10	40
BLUE CLAY	40	90
ROCK & COARSE SAND	90	180

RECEIVED


NOV 12 1986

Department of Natural Resources
Bureau of Land & Water Resources

DRILLERS REMARKS:

If well telescopes please sketch and show depths.

GROUND LEVEL

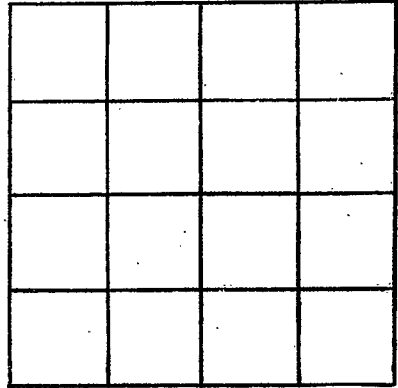

SECTION _____

Please indicate well location X.

ADDITIONAL INFORMATION

If more than one screen,
show locations of each on sketch.