

MISSISSIPPI DEPARTMENT OF NATURAL RESOURCES

Bureau of Land and Water Resources

Southport Mall

P.O. Box 10631

Jackson, Mississippi 39209

WATER WELL DRILLERS LOG

BOATOTDC
B 2012

DEC 1986  
date well completed

86 Leeper Drilling  
firm name

Pontotoc  
county well located

LANDOWNER: Donald Matthews  
RT 1 ECRU, MS.

(mailing address)

WELL LOCATION:

sec. 25 T 8 N R 2 E  
S W  
2 miles NW of ECRU  
(distance) (direction) (nearest town)

WELL PURPOSE: Home  
(home, irrigation, municipal, industrial)

WELL COMPLETION DATA:

- (1) diameter (inches) 4"
- (2) total depth (feet) 160'
- (3) static water level (feet) 50' <sup>below</sup>/<sub>above</sub> top of ground.
- (4) casing PVC, 150' (depth)  
4" (size) if telescope see back.
- (5) screen 10' (length), 150' (depth to top)  
4" (size), PVC (material)
- (6) pump 1 (HP), 10 (yield gpm)  
Elec (type power)
- (7) electric log NO (yes or no)

(organization running log)

(8) how well bottom plugged Back -  
WASH VALVE

DRILLERS REMARKS:

description of formations encountered

from to

TOP CLAY	0	12
ROCK & Red SAND	12	40
BLUE CLAY	40	100
SAND	100	160


RECEIVED

DEC 24 1986

Department of Natural Resources  
Bureau of Land & Water Resources

If well telescopes please  
sketch and show depths.

GROUND LEVEL

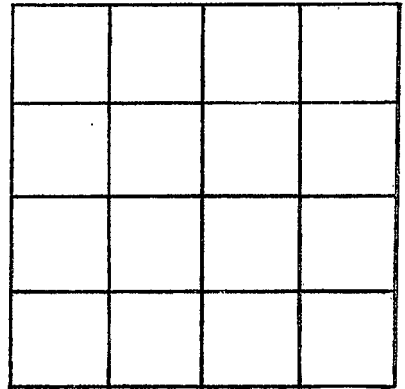

SECTION \_\_\_\_\_

Please indicate well location X.

ADDITIONAL INFORMATION

If more than one screen,  
show locations of each on sketch.