

CODED

ELOG #24

Pontotoc
C-36
7-68

MISSISSIPPI
BOARD OF WATER COMMISSIONERS
416 North State Street
Jackson, Mississippi 39201

CODED

WATER WELL DRILLERS LOG

Sept. 1968 Robert E. Kelly Pontotoc
date well completed firm name county well located

LANDOWNER: City of Pontotoc, Miss.
(mailing address)

description of formations encountered from to


WELL LOCATION:
sec. 32 T. 9 N. R. 3 E
(distance) (direction) (nearest town)

Red clay	0	58
Sand	58	76
hard clay	76	106
sand	106	180
clay	180	220
sandy clay	220	260
sandy shale w/ H. clay, streaks	260	530
gray muddy sand	530	580
hard clay	580	720
sandy shale	720	780
fine gray sand	780	820
hard clay	820	950
gray sand	950	1100
gray sand	1100	1140
hard white clay	1140	1150
sand	1150	1175
hard clay	1175	1185
sand	1185	1206
hard clay	1206	1215
sand	1215	1236
hard clay	1236	1240
sand	1240	1260
hard white rock	1260	1500

WELL PURPOSE: Municipal
(home, irrigation, municipal, industrial)

WELL COMPLETION DATA:
(1) diameter (inches) 12 x 8
(2) total depth (feet) 1188
(3) static water level (feet) 330 below top of ground.
(4) casing 8" P. steel (material) 1108 (depth)
12" If telescope see back. (size)
(5) screen 80' 1108 (length) (depth to top)
8" P. steel (size) (material)
(6) pump 125 500 (HP) (yield gpm)
electric (type power)
(7) electric log NO (yes or no)
U. S. G. S. (organization running log)
(8) how well bottom plugged S. S. Plot

CODED

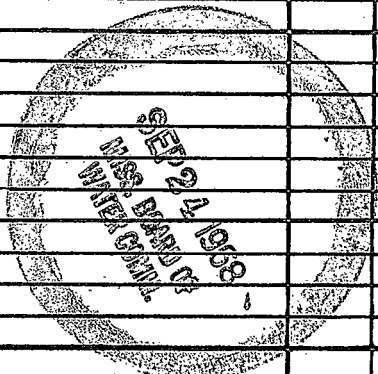

DRILLERS REMARKS:

