

Pontotoc
C 38
11-15-68

MISSISSIPPI
BOARD OF WATER COMMISSIONERS
416 North State Street
Jackson, Mississippi 39201

WATER WELL DRILLERS LOG

11-15-68 19 GAMAH WILDER PONTOTOC
date well completed firm name county well located

LANDOWNER:
PETE SMITH AKA MAN
PONTOTOC, MISS
(mailing address)

description of formations encountered	from	to
<u>Red CLAY</u>	<u>0</u>	<u>30</u>
<u>LIMESTONE</u>	<u>30</u>	<u>55</u>
<u>BLUE SHALE</u>	<u>55</u>	<u>90</u>
<u>ROCK & SAND</u>	<u>90</u>	<u>172</u>

WELL LOCATION:
sec 30 T 9 N 3 E
S W
2 miles W of Pontotoc
(distance) (direction) (nearest town)

WELL PURPOSE:
(home, irrigation, municipal, industrial)

- WELL COMPLETION DATA:
- (1) diameter (inches) 4
 - (2) total depth (feet) 172
 - (3) static water level (feet) 68 below above top of ground.
 - (4) casing STEEL, 92
(material), (depth).
4" If telescope see back.
(size)
 - (5) screen ~~_____~~
(length) (depth to top)
(size) (material)
 - (6) pump 1/2 5
(HP) (yield.gpm)
ELECTRIC
(type power)
 - (7) electric log NO
(yes or no)

(organization running log)
 - (8) how well bottom plugged _____

DRILLERS REMARKS:

201511

201511

201511

MISSISSIPPI


MISSISSIPPI

MISSISSIPPI

FEB 26 1969
MISS. ED. OF
STATE ENGINEERS

If well telescopes please sketch and show depths.

GROUND LEVEL

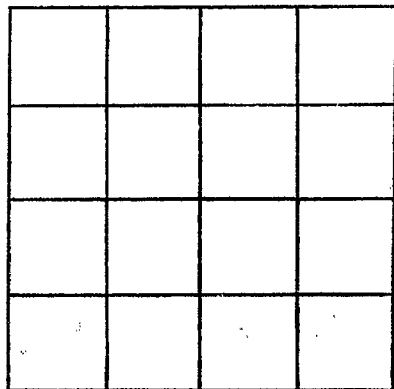

SECTION 30

Please indicate well location X.

ADDITIONAL INFORMATION

If more than one screen,
show locations of each on sketch.