

Pontotoc
C 39
2-11-69

MISSISSIPPI
BOARD OF WATER COMMISSIONERS
416 North State Street
Jackson, Mississippi 39201

CODED

CODED

WATER WELL DRILLERS LOG

2-11-69 19 Living your Well Drilling Co potatoe
date well completed firm name county well located

LANDOWNER: Adrian Miller

description of formations encountered	from	to
<u>Joint Clay Sand</u>	<u>0</u>	<u>65</u>
<u>Blue sand</u>	<u>65</u>	<u>90</u>
	<u>20</u>	<u>218</u>

RT 3 potatoe
(mailing address)

WELL LOCATION:
sec. 2 T 9 N R 3 E
S W
miles _____ of _____
(distance) (direction) (nearest town)

WELL PURPOSE:
(home, irrigation, municipal, industrial)

- WELL COMPLETION DATA:
- (1) diameter (inches) 4
 - (2) total depth (feet) 219
 - (3) static water level (feet) 105 below above top of ground.
 - (4) casing CT 270'
(material) (depth)
_____ if telescope see back.
(size)
 - (5) screen _____
(length) (depth to top)
_____ (size) _____ (material)
 - (6) pump 3/4 350'
(HP) (yield gpm)
EP 220
(type power)
 - (7) electric log _____
(yes or no)
_____ (organization running log)
 - (8) how well bottom plugged _____

CODED


FEB 13 1969

MISS. DE. OF
WATER CONTROL

DRILLERS REMARKS:

If well telescopes please sketch and show depths.

GROUND LEVEL

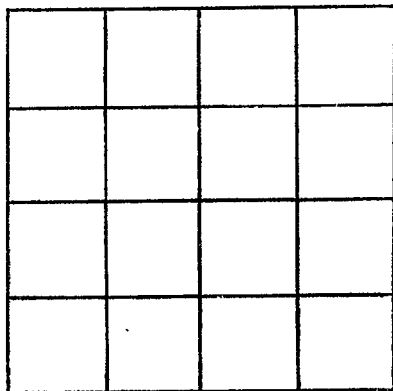

SECTION _____

Please indicate well location X.

ADDITIONAL INFORMATION

If more than one screen,
show locations of each on sketch.