

CODED

Pontotoc
C40
5-16-69

MISSISSIPPI
BOARD OF WATER COMMISSIONERS
416 North State Street
Jackson, Mississippi 39201

WATER WELL DRILLERS LOG

May 16 1969 J. W. Webb & Son Pontotoc
date well completed firm name county well located

LANDOWNER: Corall Baker

Oak Hill

(mailing address)

WELL LOCATION:

sec. 2 T 95 N R 3 E
S W
7 miles east of Egan
(distance) (direction) (nearest town)

WELL PURPOSE: home
(home, irrigation, municipal, industrial)

WELL COMPLETION DATA:

- (1) diameter (inches) 4
- (2) total depth (feet) 200
- (3) static water level (feet) 80 below above top of ground.
- (4) casing steel 62' (material) (depth)
- (size) if telescope see back.
- (5) screen none (length) (depth to top)
- (size) (material)
- (6) pump none (HP) (yield gpm)
- (type power)
- (7) electric log no (yes or no)
- (organization running log)
- (8) how well bottom plugged

description of formations encountered

from

to

Red Clay	0	15
Clay & sand	15	25
sand	25	45
sandy Blue marl	45	50
Blue marl	50	75
Wet sand	75	200


DRILLERS REMARKS:

MISS. RD. OF
WATER COM.

JUL 9 1969

If well telescopes please sketch and show depths.

GROUND LEVEL

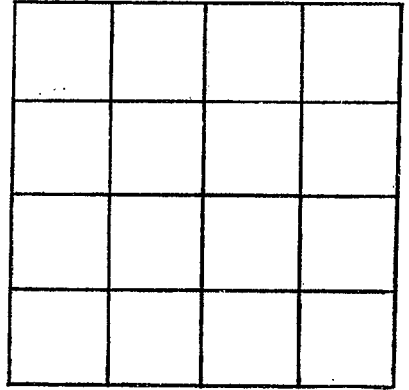

SECTION 2

Please indicate well location X.

ADDITIONAL INFORMATION

If more than one screen, show locations of each on sketch.