

CODED

MISSISSIPPI
BOARD OF WATER COMMISSIONERS
416 North State Street
Jackson, Mississippi 39201

WATER WELL DRILLERS LOG

Pontotoc
CAI
7-69

7-21 1969 Clark Bros Pontotoc
date well completed firm name county well located

LANDOWNER:
Lorman Belden
Pontotoc
(mailing address)

description of formations encountered	from	to
Shandy		
Red Clay	0	16
Rock & Sand	16	56
Blue Mud	56	150
Rock & Sand	150	200

WELL LOCATION:
sec. 33 T. 8 N. R. 3 E.
S. W.
9 miles N-E of Pontotoc
(distance) (direction) (nearest town)

WELL PURPOSE: Home
(home, irrigation, municipal, industrial)

- WELL COMPLETION DATA:
- (1) diameter (inches) 4
 - (2) total depth (feet) 200
 - (3) static water level (feet) 100 below top of ground.
 - (4) casing Metal, 66 (material) (depth), 4 (size) if telescope see back.
 - (5) screen none (length) (depth to top) (size) (material)
 - (6) pump 1 hp, 4 (HP) (yield gpm), Electric (type power)
 - (7) electric log no (yes or no) (organization running log)
 - (8) how well bottom plugged no


AUG 7 1969

DRILLERS REMARKS:

MISS. BD. OF
WATER COMM.

If well telescopes please sketch and show depths.

GROUND LEVEL

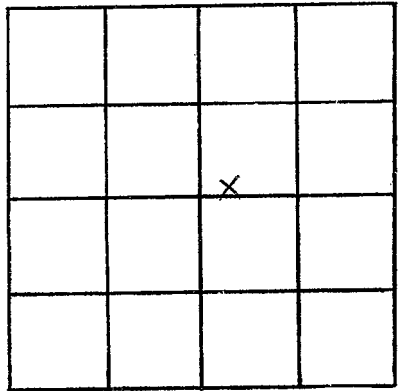

SECTION _____

Please indicate well location X.

ADDITIONAL INFORMATION

If more than one screen, show locations of each on sketch.