

Pontotoc
C. 44
2-20-70

MISSISSIPPI
BOARD OF WATER COMMISSIONERS
416 North State Street
Jackson, Mississippi 39201

WATER WELL DRILLERS LOG

CODED

2-20 1970 LAMAR WILDER PONTOTOC
date well completed firm name county well located

LANDOWNER:	description of formations encountered	from	to
RAY McCAUER RT-2 - PONTOTOC, MISS (mailing address)	Red CLAY BLUE SHALE ROCK & SAND	0 420 100	40 100 176
WELL LOCATION: sec. 9 T. 9 R. 3 2 miles S of FLDU (distance) (direction) (nearest town)			
WELL PURPOSE: HOME (home, irrigation, municipal, industrial)			
WELL COMPLETION DATA:			
(1) diameter (inches) 4			
(2) total depth (feet) 136			
(3) static water level (feet) 90 below top of ground.			
(4) casing STEEL 84 (material) (depth) 4" If telescope see back. (size)			
(5) screen IRON 5 (length) (depth to top) (size) (material)			
(6) pump 1/2 5 (HP) (yield gpm) ELECT (type power)			
(7) electric log _____ (yes or no) (organization running log)			
(8) how well bottom plugged _____			
DRILLERS REMARKS:			


MAR 3 1970

MISS. BO. OF
WATER COMM.

CODED

If well telescopes please sketch and show depths.

GROUND LEVEL

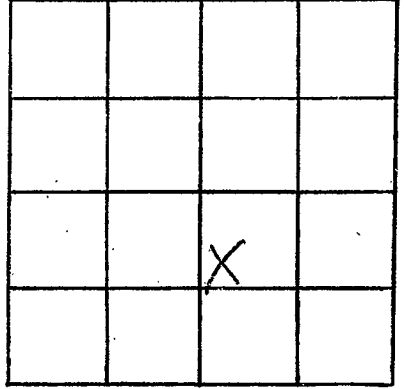

SECTION _____

Please indicate well location X.

ADDITIONAL INFORMATION

If more than one screen,
show locations of each on sketch.