

Pontotoc
 C 45
 6-1-70

MISSISSIPPI
 BOARD OF WATER COMMISSIONERS
 416 North State Street
 Jackson, Mississippi 39201

CODED

WATER WELL DRILLERS LOG

6-1-1970 date well completed
 Clark Bros firm name
 Pontotoc county well located

LANDOWNER: Therado Golden
Pontotoc Route
 (mailing address)

WELL LOCATION:
 sec. 27 T 8 S R 3 E
9 miles N of Pontotoc
 (distance) (direction) (nearest town)

description of formations encountered	from	to
Red clay	0	30
Rock & sand	30	70
Blue mud	70	200
Rock & sand	200	265

WELL PURPOSE: Home
 (home, irrigation, municipal, industrial)

WELL COMPLETION DATA:

(1) diameter (inches) 4"

(2) total depth (feet) 265'

(3) static water level (feet) 108' below above top of ground.

(4) casing Met, 84'
 (material) (depth)
4" if telescope see back.
 (size)

(5) screen None
 (length) (depth to top)
 (size) (material)

(6) pump Red 4
 (HP) (yield gpm)
Electric
 (type power)

(7) electric log no
 (yes or no)
 (organization running log)

(8) how well bottom plugged 100

CODED


1970

DRILLERS REMARKS:

MISS. BD. OF
 WATER COMM.

If well telescopes please sketch and show depths.

GROUND LEVEL

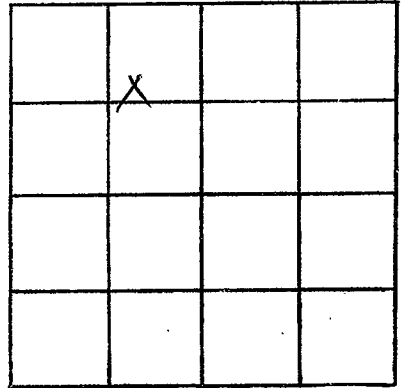

SECTION _____

Please indicate well location X.

ADDITIONAL INFORMATION

If more than one screen, show locations of each on sketch.