

MISSISSIPPI
BOARD OF WATER COMMISSIONERS
416 North State Street
Jackson, Mississippi 39201

CODED

WATER WELL DRILLERS LOG

Pontotoc
C 46
6-4-70

6-4-1970 date well completed
J T Medlin firm name
Pontotoc county well located

LANDOWNER:

Samuel R. ...
PONTOTOC
(mailing address)

description of formations encountered

description of formations encountered	from	to
Red CLAY	0	21
Red SAND	21	68
Blue CLAY + Shell	68	106
Rock	106	118
SAND	118	148
Blue CLAY	148	158
SAND	158	171
Blue "	171	206

WELL LOCATION:

sec. 15 T-9 N R-30
5 miles N.E. of Pontotoc
(distance) (direction) (nearest town)

WELL PURPOSE:

(home, irrigation, municipal, industrial)

WELL COMPLETION DATA:

- (1) diameter (inches) 4
- (2) total depth (feet) 206
- (3) static water level (feet) 100 below above top of ground.
- (4) casing P 26
(material) (depth)
4 If telescope see back.
(size)
- (5) screen 0
(length) (depth to top)
(size) (material)
- (6) pump 1 3
(HP) (yield gpm)
E
(type power)
- (7) electric log (yes or no)

CODED

JUL 2 1970

(organization running log)


(8) how well bottom plugged Open

MISS. BD. OF
WATER COMM.

DRILLERS REMARKS:

If well telescopes please sketch and show depths.

GROUND LEVEL

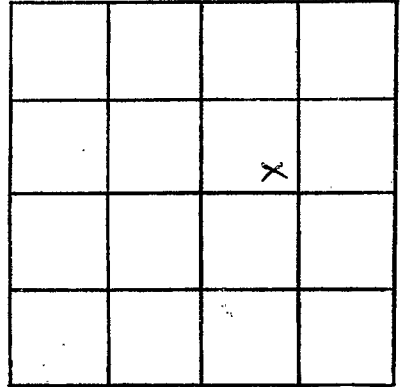

SECTION 15

Please indicate well location X.

ADDITIONAL INFORMATION

If more than one screen,
show locations of each on sketch.