

PONTOTOC  
 C49  
 7-27-70

MISSISSIPPI  
 BOARD OF WATER COMMISSIONERS  
 416 North State Street  
 Jackson, Mississippi 39201

**CODED**

WATER WELL DRILLERS LOG

7-27 1970 Clark Bros Pontotoc  
 date well completed firm name county well located

LANDOWNER:  
 Mrs. Fred Wicken  
 Pontotoc  
 (mailing address)

description of formations encountered	from	to
Red clay	0	15
Rock & sand	15	60
Blue mud	60	100
Rock & sand	100	200

WELL LOCATION:  
 sec. 27 T. 9 N. R. 3 E.  
 5 miles NE of Pontotoc  
 (distance) (direction) (nearest town)

WELL PURPOSE: Home  
 (home, irrigation, municipal, industrial)

WELL COMPLETION DATA:

(1) diameter (inches) 4"  
 (2) total depth (feet) 200'  
 (3) static water level (feet) 108' below top of ground.  
 (4) casing metal, 24' (depth)  
 4" (size) if telescope see back.  
 (5) screen none (length) (depth to top)  
 (size) (material)  
 (6) pump Jet 4 (type power) (yield gpm)  
 Electric  
 (7) electric log no (yes or no)  
 (organization running log)  
 (8) how well bottom plugged no

**CODED**


AUG 6 1970

MISS. BD. OF  
 WATER COMMISSIONERS

DRILLERS REMARKS:

If well telescopes please sketch and show depths.

GROUND LEVEL

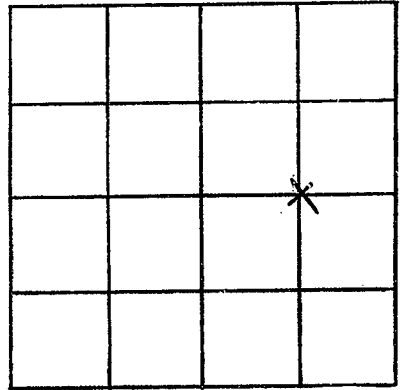

SECTION \_\_\_\_\_

Please indicate well location X.

ADDITIONAL INFORMATION

If more than one screen, show locations of each on sketch.