

Pontotoc
 C50
 12-67

MISSISSIPPI
 BOARD OF WATER COMMISSIONERS
 416 North State Street
 Jackson, Mississippi 39201

CODED

WATER WELL DRILLERS LOG

12-4-67 19 Lamor Wilder PONTOTOC
 date well completed firm name county well located

LANDOWNER:
WAYMON LYONS
ECHO, MISS-
 (mailing address)

description of formations encountered	from	to
Red CLAY	0	40
BLUE SHALE	40	80
GREY ROCK	80	110
ROCK + SAND	110	112

WELL LOCATION:
 sec 5 T 8 N R 3 E
 S #
 (distance) miles (direction) of (nearest town)

WELL PURPOSE:
 (home, irrigation, municipal, industrial)

WELL COMPLETION DATA:

(1) diameter (inches) 4

(2) total depth (feet) 162

(3) static water level (feet) 59 below above top of ground.

(4) casing STEEL, 60,
 (material) (depth)
4"
 (size) if telescope see back.


(5) screen 0,
 (length) (depth to top)
 (size) (material)

(6) pump 1, 7
 (HP) (yield gpm)
ELECTRIC
 (type power)

(7) electric log NO
 (yes or no)
 (organization running log)

(8) how well bottom plugged

CODED

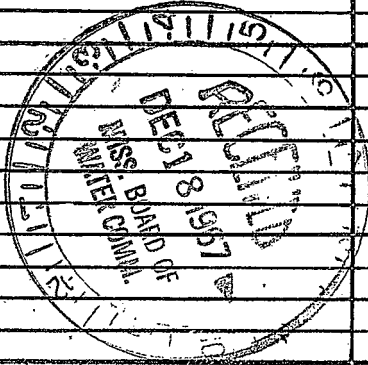

DRILLERS REMARKS:

If well telescopes please sketch and show depths.

GROUND LEVEL

X			

SECTION 2

Please indicate well location X.

ADDITIONAL INFORMATION

If more than one screen, show locations of each on sketch.