

PONTOTOC
 C52
 11-15-70

MISSISSIPPI
 BOARD OF WATER COMMISSIONERS
 416 North State Street
 Jackson, Mississippi 39201

CODED

WATER WELL DRILLERS LOG

~~11-15~~ 11-15 1970 Clark Bros. Pontotoc
 date well completed firm name county well located

LANDOWNER:
Jack Comings
Route 2, Pontotoc
 (mailing address)

description of formations encountered	from	to
<u>Red Clay</u>	<u>0</u>	<u>20</u>
<u>Lime Rock</u>	<u>20</u>	<u>60</u>
<u>Blue mud</u>	<u>60</u>	<u>130</u>
<u>Rock & Sand</u>	<u>130</u>	<u>200</u>

WELL LOCATION:
 sec. 13 T. 9 S. R. 3 E.
6 miles N of Pontotoc
 (distance) (direction) (nearest town)

WELL PURPOSE: Home
 (home, irrigation, municipal, industrial)

- WELL COMPLETION DATA:
- diameter (inches) 4"
 - total depth (feet) 200'
 - static water level (feet) 65' below above top of ground.
 - casing Metal, 84'
 (material) (depth)
4"
 (size) if telescope see back.
 - screen None
 (length) (depth to top)
 (size) (material)
 - pump 1 1/2 HP 6
 (HP) (yield gpm)
Electric
 (type power)
 - electric log no
 (yes or no)
 (organization running log)
 - how well bottom plugged no

CODED


JAN 4 - 1971

DRILLERS REMARKS:

MISS. BD. OF
 WATER COMM.

If well telescopes please sketch and show depths.

GROUND LEVEL

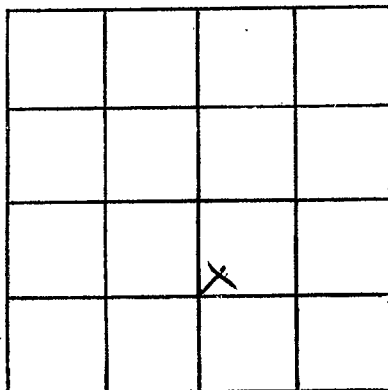

SECTION _____

Please indicate well location X.

ADDITIONAL INFORMATION

If more than one screen,
show locations of each on sketch.