

PONTOTOC
C 53
11-28-70

MISSISSIPPI
 BOARD OF WATER COMMISSIONERS
 416 North State Street
 Jackson, Mississippi 39201

CODED

WATER WELL DRILLERS LOG

Nov. 28 1970 Clark Bros. Pontotoc
 date well completed firm name county well located

LANDOWNER:
Jimmy Huffstader
Box 80, ECU
 (mailing address)

description of formations encountered	from	to
<u>Red Clay</u>	<u>0</u>	<u>22</u>
<u>Lime Rock & Sand</u>	<u>22</u>	<u>40</u>
<u>Blue mud</u>	<u>40</u>	<u>110</u>
<u>Rock & Sand</u>	<u>110</u>	<u>200</u>

WELL LOCATION:
 sec. 28 T. 46 N. R. 30 E.
3 miles SE of ECU
 (distance) (direction) (nearest town)

WELL PURPOSE: Home
 (home, irrigation, municipal, industrial)

- WELL COMPLETION DATA:
- diameter (inches) 4"
 - total depth (feet) 200'
 - static water level (feet) 60' below above top of ground.
 - casing Metal, 43'
 (material) (depth)
4" if telescope see back.
 (size)
 - screen None
 (length) (depth to top)
 (size) (material)
 - pump 3/4 hp 4
 (HP) (yield gpm)
Electric
 (type power)
 - electric log no
 (yes or no)
 (organization running log)
 - how well bottom plugged no

CODED


JAN 4 1971

DRILLERS REMARKS:

MISS. BD. OF
 WATER COMM.

If well telescopes please sketch and show depths.

GROUND LEVEL

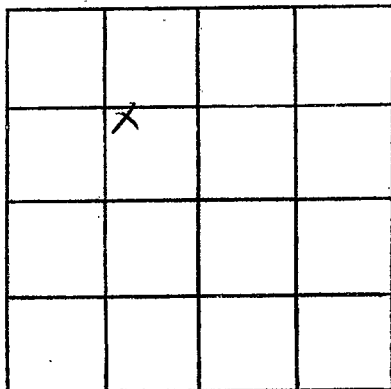

SECTION _____

Please indicate well location X.

ADDITIONAL INFORMATION

If more than one screen, show locations of each on sketch.