

MISSISSIPPI  
BOARD OF WATER COMMISSIONERS  
416 North State Street  
Jackson, Mississippi 39201

**CODED**

WATER WELL DRILLERS LOG

PONTOTOC  
C 54  
1-23-71

1-23-71 date well completed 1971 J T Modlin firm name Pontotoc county well located

LANDOWNER: Charles Hardy  
Pontotoc  
(mailing address)

description of formations encountered	from	to
	Red Clay	0
Blue "f" & Boett	27	27
Sand	27	130
Blue	138	140

WELL LOCATION:  
sec. 11 T. 9 N. R. 3 E  
6 miles N.E. of Pontotoc  
(distance) (direction) (nearest town)

WELL PURPOSE:  
(home, irrigation, municipal, industrial)

- WELL COMPLETION DATA:
- (1) diameter (inches) 4
  - (2) total depth (feet) 140
  - (3) static water level (feet) 96 below top of ground.
  - (4) casing P, 140,  
(material) (depth)  
(size) if telescope see back.
  - (5) screen 20, 120  
(length) (depth to top)  
4, P  
(size) (material)
  - (6) pump 1/2, 6  
(HP) (yield gpm)  
E  
(type power)
  - (7) electric log (yes or no)
  - (organization running log)
  - (8) how well bottom plugged Blue

**CODED**


FEB 2 1971

MISS. BD. OF  
WATER COMMISSIONERS

DRILLERS REMARKS:

If well telescopes please  
sketch and show depths.

GROUND LEVEL

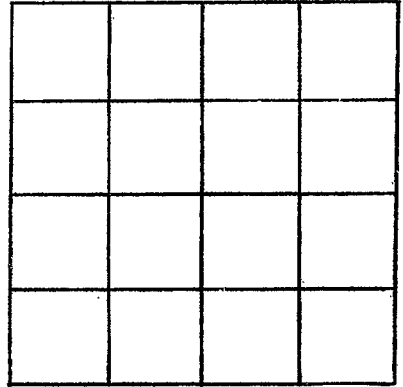

SECTION \_\_\_\_\_

Please indicate well location X.

ADDITIONAL INFORMATION

If more than one screen,  
show locations of each on sketch.