

PONTOTOC
C 55
1-27-71

MISSISSIPPI
BOARD OF WATER COMMISSIONERS
416 North State Street
Jackson, Mississippi 39201

CODED

WATER WELL DRILLERS LOG

1-27 1971 date well completed
Clark Bros. firm name
Pontotoc county well located

LANDOWNER:
R. E. Tetem
Pontotoc Rt-2
(mailing address)

description of formations encountered	from	to
Red clay	0	15
Rock & sand	15	45
Blue mud	45	135
Rock & sand	135	200

WELL LOCATION:
sec. 16 T 9 S R. 3 E
9 miles N of Pontotoc
(distance) (direction) (nearest town)

WELL PURPOSE: Home
(home, irrigation, municipal, industrial)

- WELL COMPLETION DATA:
- (1) diameter (inches) 4"
 - (2) total depth (feet) 200'
 - (3) static water level (feet) 95' below top of ground.
 - (4) casing Metal 59' (material) (depth)
4" (size) if telescope see back.
 - (5) screen None (length) (depth to top)
(size) (material)
 - (6) pump 1 1/2 (HP) 4 (yield gpm)
Electric (type power)
 - (7) electric log no (yes or no)
(organization running log)
 - (8) how well bottom plugged 500

CODED


MAR 13 1971

MISS. Bd. of WATER COMMISSIONERS

DRILLERS REMARKS:

If well telescopes please sketch and show depths.

GROUND LEVEL

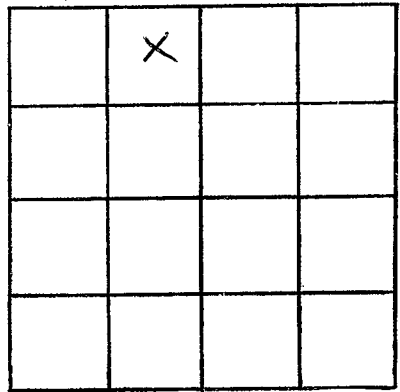

SECTION _____

Please indicate well location X.

ADDITIONAL INFORMATION

If more than one screen, show locations of each on sketch.