

Pontotoc
OC-60
6-66

WATER WELL DRILLERS LOG

CODED

Date: **CODED** 19 66, Driller: James S. Co. County: St. Louis
(Name)

(1) Owner of Land: H.C. Austin
(Name)
Pontotoc Rt 1
(Address)

(2) Location: 1/4, 1/4, Sec. 31 T2R3E
1 miles W, of Pontotoc
(distance) (direction) (Nearest Town)

(3) Topography: Hilly
(Hilly) (Flat) (Level)

(4) Purpose of Well: Domestic
(Domestic Irrigation
Municipal, Industrial, Other)

Description & Color of Materials Sand, Clay, Red Clay, Shell, etc.	Thick- ness Feet	Depth Feet
<u>gray clay</u>	<u>0</u>	<u>80</u>
<u>Blue</u>	<u>80</u>	<u>100</u>
<u>Water Sand & Rocks</u>	<u>100</u>	<u>193</u>

Information upon completion of well:

(1) Diameter 4 inches.

(2) Total Depth 193 feet.

(3) Water Level 70 feet below top of ground.

(4) Cased to 84 ft, Size 4 in.

(5) Screen: Size _____, Length _____


(6) Were any formations sealed against pollution?
Yes yes, _____ no.

CODED

If YES depth of formation 30"

Why Bitter - lime water

Drillers Remarks:

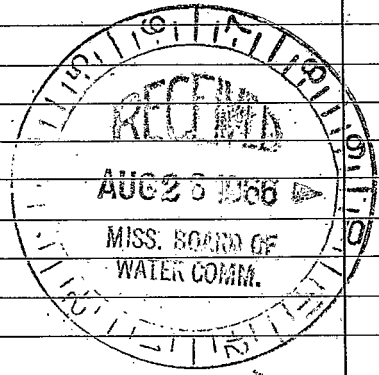

(Use Back Side)

Well No.

