

CODED

MISSISSIPPI
 BOARD OF WATER COMMISSIONERS
 416 North State Street
 Jackson, Mississippi 39201

WATER WELL DRILLERS LOG

Pontotoc
 C.62
 5-67

5-14-67 1967 Lamar Weller Wells - Pontotoc
 date well completed firm name county well located

LANDOWNER:

Jim Dillard
 E. C. W. Miss -
 (mailing address)

description of formations encountered

from to

Red CLAY & SAND	0	30
Red & sand	30	30
BLUE SAND E	50	96
Red & sand -	96	196

WELL LOCATION:

sec. 26 T. 8 N. R. 3 E.
 S. 3 miles E of ECW
 (distance) (direction) (nearest town)


WELL PURPOSE:

(home, irrigation, municipal, industrial)

WELL COMPLETION DATA:


- (1) diameter (inches) 4 1/2
- (2) total depth (feet) 196
- (3) static water level (feet) 60 below above top of ground.
- (4) casing STEEL, 68,
 (material) (depth)
4" if telescope see back.
 (size)
- (5) screen _____
 (length) (depth to top)
 (size) (material)
- (6) pump LAP 7
 (HP) (yield gpm)
 (type power)
- (7) electric log _____
 (yes or no)
 (organization running log)
- (8) how well bottom plugged _____

CODED

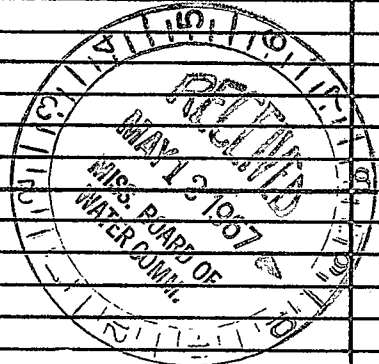**DRILLERS REMARKS:**

If well telescopes please sketch and show depths.

GROUND LEVEL

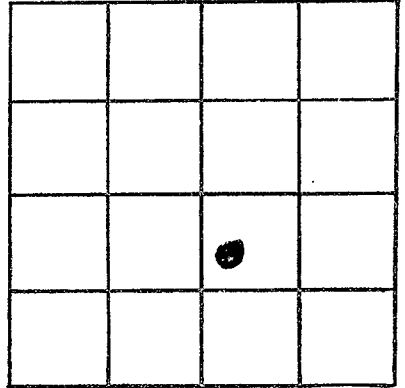

SECTION 26

Please indicate well location X.

ADDITIONAL INFORMATION

If more than one screen, show locations of each on sketch.