

CODED

MISSISSIPPI
BOARD OF WATER COMMISSIONERS
416 North State Street
Jackson, Mississippi 39201

CODED

WATER WELL DRILLERS LOG

Pontotoc
C-63
9-67

LAMAR WILBER

PONTOTOC

9-12-67
date well completed

firm name

county well located

LANDOWNER:

Howard McCord

description of formations encountered

from to

PONTOTOC, MISS
(mailing address)

Red CLAY 0 20
LIME STONE 20 40
BLUE SHALE 40 85
SAND & ROCK 85 160
BLUE SHALE 160 168

WELL LOCATION:

sec 19 T 9 S R 3 E
3 miles N of PONTOTOC
(distance) (direction) (nearest town)

WELL PURPOSE: HOE PARLOR
(home, irrigation, municipal, industrial)

WELL COMPLETION DATA:

- (1) diameter (inches)
- (2) total depth (feet) 168
- (3) static water level (feet) below above top of ground.
- (4) casing STEEL, 63" (material), (depth)

if telescope see back.
(size)

- (5) screen NONE (length) (depth to top)

(size) (material)
(6) pump 1/3 350 GPH (HP) (yield gpm)

ELECTRIC
(type power)


- (7) electric log NO (yes or no)

(organization running log)

- (8) how well bottom plugged

DRILLERS REMARKS:

CODED

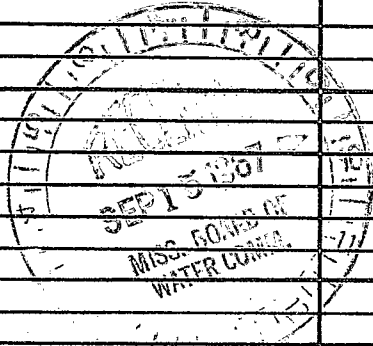

If well telescopes please sketch and show depths.

GROUND LEVEL

			0

SECTION 19

Please indicate well location X.

ADDITIONAL INFORMATION

If more than one screen, show locations of each on sketch.