

CODED

Pontotoc
C64
10-67

MISSISSIPPI
BOARD OF WATER COMMISSIONERS
416 North State Street
Jackson, Mississippi 39201

WATER WELL DRILLERS LOG

CODED

10-13-67
date well completed

19 Lamar Wilder
firm name

PONTOTOC
county well located


LANDOWNER:
MAX HOMAN
RT-2-PONTOTOC
(mailing address)

description of formations encountered	from	to
<u>RED CLAY + SAND</u>	<u>0</u>	<u>25</u>
<u>BLUE SHALE</u>	<u>25</u>	<u>90</u>
<u>ROCK SAND</u>	<u>90</u>	<u>160</u>

WELL LOCATION:
sec. 16 T. 9 N R. 3 E
S
5 miles N of PONTOTOC
(distance) (direction) (nearest town)

WELL PURPOSE: HOME
(home, irrigation, municipal, industrial)


- WELL COMPLETION DATA:
- (1) diameter (inches) 4
 - (2) total depth (feet) 160
 - (3) static water level (feet) 80 below above top of ground.
 - (4) casing STEEL, 70
(material) (depth)
4" if telescope see back.
(size)
 - (5) screen _____
(length) (depth to top)
(size) (material)
 - (6) pump 1 6
(HP) (yield gpm)
ELECTRIC
(type power)
 - (7) electric log NO
(yes or no)
(organization running log)
 - (8) how well bottom plugged _____

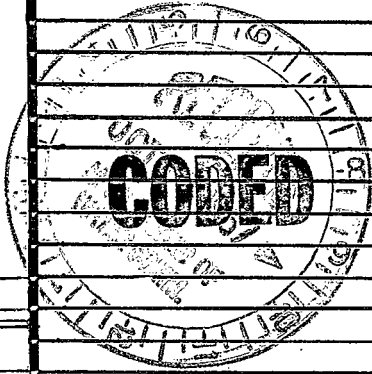

DRILLERS REMARKS:

If well telescopes please sketch and show depths.

GROUND LEVEL

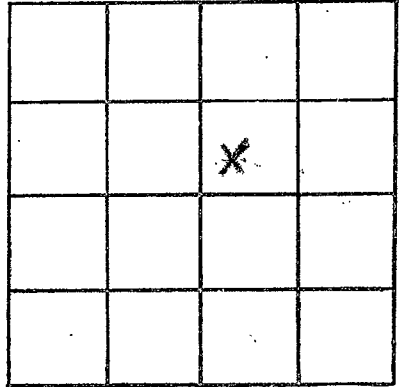

SECTION 15

Please indicate well location X.

ADDITIONAL INFORMATION

If more than one screen,
show locations of each on sketch.