

CODED

Pontotoc
C 65
11-67

MISSISSIPPI
BOARD OF WATER COMMISSIONERS
416 North State Street
Jackson, Mississippi 39201

CODED

WATER WELL DRILLERS LOG

11-31-67 19 Lamar Miller PONTOTOC
date well completed firm name county well located

LANDOWNER:

ROBERT MILLS
RT 3 - PONTOTOC
(mailing address)

description of formations encountered

from

to

Red CLAY 0 55
BLUE SHALE (ROCKY) 55 110
ROCK & SAND 110 176

WELL LOCATION:

sec. 11 T 9 N R 3 E
S
8 miles NE of PONTOTOC
(distance) (direction) (nearest town)


WELL PURPOSE:

(home, irrigation, municipal, industrial)

WELL COMPLETION DATA:


- (1) diameter (inches) 4
- (2) total depth (feet) 196
- (3) static water level (feet) 80 below above top of ground.
- (4) casing STEEL, 96
(material) (depth)
4" if telescope see back.
(size)
- (5) screen _____
(length) (depth to top)
(size) (material)
- (6) pump 3/8 8
(HP) (yield gpm)
ELECTRIC
(type power)
- (7) electric log NO
(yes or no)
(organization running log)
- (8) how well bottom plugged _____

DRILLERS REMARKS:

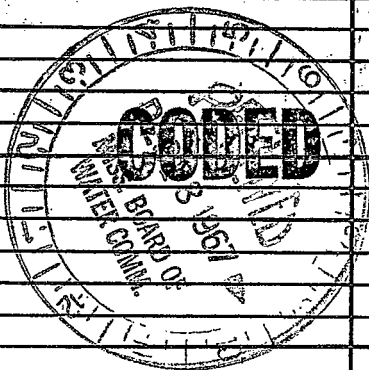

If well telescopes please sketch and show depths.

GROUND LEVEL

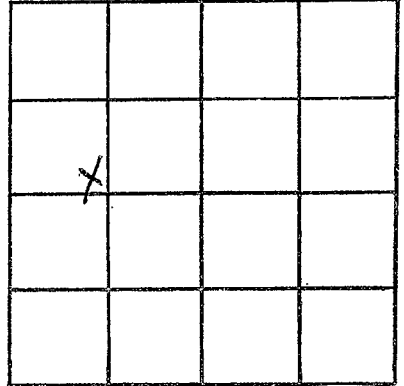

SECTION 11

Please indicate well location X.

ADDITIONAL INFORMATION

If more than one screen,
show locations of each on sketch.