

CODED

Pontotoc
C 66
12-67

MISSISSIPPI
BOARD OF WATER COMMISSIONERS
416 North State Street
Jackson, Mississippi 39201

CODED

WATER WELL DRILLERS LOG

12-16-67 19 Lamer Miller PONTOTOC
date well completed firm name county well located

LANDOWNER:

FRED CONWAY

description of formations encountered

from to

RT-1-BLUESHINGS
(mailing address)

Red CLAY 0 45
LIMESTONE 45 70
BLUESHALE 70 100
ROCK & SAND 100 165


WELL LOCATION:

sec 7 T 8 S R 3 E
3 miles 6 of ECW
(distance) (direction) (nearest town)

WELL PURPOSE: HOME
(home, irrigation, municipal, industrial)

WELL COMPLETION DATA:


- (1) diameter (inches) 4
- (2) total depth (feet) 165
- (3) static water level (feet) 84 below above top of ground.
- (4) casing STEEL, 84,
(material) (depth)
4" if telescope see back.
(size)
- (5) screen _____
(length) (depth to top)
(size) (material)
- (6) pump 3/4 6
(HP) (yield gpm)
ELECTRIC
(type power)
- (7) electric log NO
(yes or no)
(organization running log)
- (8) how well bottom plugged _____

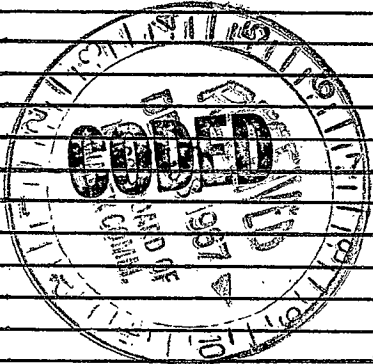

DRILLERS REMARKS:

If well telescopes please sketch and show depths.

GROUND LEVEL

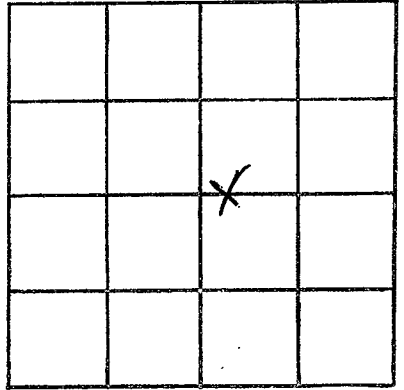

SECTION 27

Please indicate well location X.

ADDITIONAL INFORMATION

If more than one screen, show locations of each on sketch.