

CODED

MISSISSIPPI
 BOARD OF WATER COMMISSIONERS
 416 North State Street
 Jackson, Mississippi 39201

CODED

WATER WELL DRILLERS LOG

Pontotoc
C 67
3-68

3-14 1968 LAMAR WILDER PONTOTOC
 date well completed firm name county well located

LANDOWNER:
Lloyd BALDWIN
RT-2 - PONTOTOC, MISS.
 (mailing address)

description of formations encountered	from	to
<u>Red CLAY</u>	<u>0</u>	<u>35</u>
<u>LIMESTONE</u>	<u>35</u>	<u>50</u>
<u>BLUE SHALE</u>	<u>50</u>	<u>95</u>
<u>ROCK & SAND</u>	<u>95</u>	<u>180</u>


WELL LOCATION:
 sec. 8 T 9 S R 3 E
5 miles N of PONTOTOC
 (distance) (direction) (nearest town)

WELL PURPOSE: HOME
 (home, irrigation, municipal, industrial)

- WELL COMPLETION DATA:
- diameter (inches) 4
 - total depth (feet) 180
 - static water level (feet) 126 below above top of ground.
 - casing STEEL, 69
 (material) (depth)
 _____ if telescope see back.
 (size)
 - screen _____
 (length) (depth to top)

 (size) (material)
 - pump 1 5
 (HP) (yield gpm)
ELECTRIC
 (type power)
 - electric log NO
 (yes or no)


 (organization running log)
 - how well bottom plugged _____

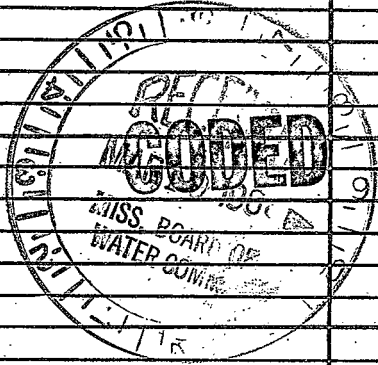

DRILLERS REMARKS:

If well telescopes please sketch and show depths.

GROUND LEVEL

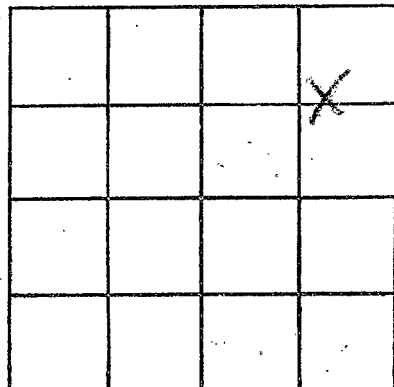

SECTION _____

Please indicate well location X.

ADDITIONAL INFORMATION

If more than one screen, show locations of each on sketch.