

CODED

Pontotoc
C69
7-26-68

MISSISSIPPI
BOARD OF WATER COMMISSIONERS
416 North State Street
Jackson, Mississippi 39201

CODED

WATER WELL DRILLERS LOG

7-26 1968 date well completed
Clark Bros. firm name
Pontotoc county well located

LANDOWNER:

Samuel McCard
Pontotoc, Lumbert
(mailing address)

description of formations encountered

from to

Red clay 0 20
Rock + Sand 20 100
Blue mud 100 150
Rock + Sand 150 200

WELL LOCATION:


sec 16 T 9 R 3 E
7 miles N of Pontotoc
(distance) (direction) (nearest town)

WELL PURPOSE:

Home
(home, irrigation, municipal, industrial)

WELL COMPLETION DATA:


- (1) diameter (inches) 4"
- (2) total depth (feet) 200'
- (3) static water level (feet) 70' below top of ground.
- (4) casing Metal 103' (material), (depth)
4" (size) if telescope see back.
- (5) screen None (length), (depth to top)
(size), (material)
- (6) pump 3/4 hp 5 (HP), (yield gpm)
Electric (type power)
- (7) electric log No (yes or no)
(organization running log)
- (8) how well bottom plugged No

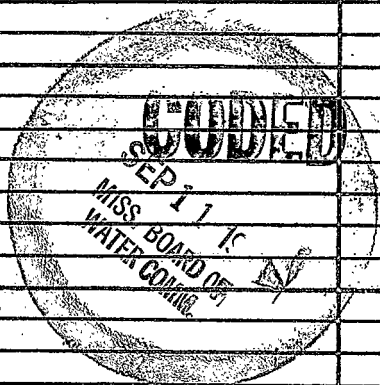

DRILLERS REMARKS:

If well telescopes please sketch and show depths.

GROUND LEVEL

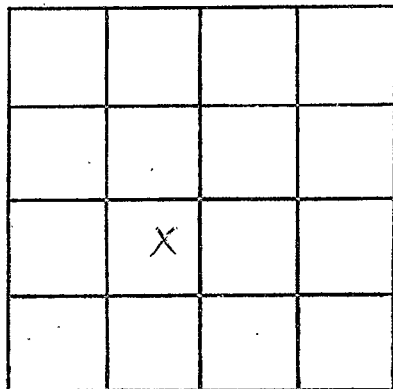

SECTION _____

Please indicate well location X.

ADDITIONAL INFORMATION

If more than one screen, show locations of each on sketch.