

CODED

Pontotoc
C-70
8-68

MISSISSIPPI
BOARD OF WATER COMMISSIONERS
416 North State Street
Jackson, Mississippi 39201

CODED

WATER WELL DRILLERS LOG

8-9 19*68* *Clark Bros* *Pontotoc*
date well completed firm name county well located

LANDOWNER:

C. B. Shettle
Pontotoc Rt
(mailing address)

description of formations encountered

from to

<i>Gravel</i>	<i>0</i>	<i>22</i>
<i>Rock</i>	<i>22</i>	<i>42</i>
<i>Sin shale</i>	<i>42</i>	<i>102</i>
<i>Blue mud</i>	<i>102</i>	<i>112</i>
<i>Rock & sand</i>	<i>112</i>	<i>200</i>

WELL LOCATION:


sec. *13* T. *9* R. *3*
6 miles *N* of *Pontotoc*
(distance) (direction) (nearest town)

WELL PURPOSE: *Home*
(home, irrigation, municipal, industrial)

WELL COMPLETION DATA:

- (1) diameter (inches) *4"*
- (2) total depth (feet) *200'*
- (3) static water level (feet) *45'* below above top of ground.
- (4) casing *Galval*, *67'*
(material) (depth)
4" if telescope see back.
(size)
- (5) screen *None*
(length) (depth to top)
(size) (material)
- (6) pump *1 jet* *7*
(HP) (yield gpm)
Electric
(type power)
- (7) electric log *no*
(yes or no)
(organization running log)
- (8) how well bottom plugged *no*


CODED

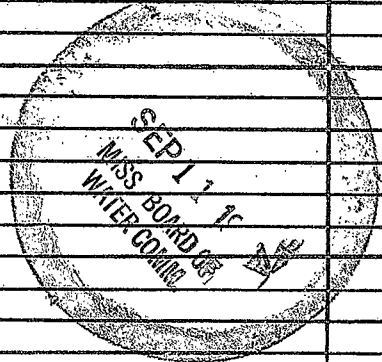

DRILLERS REMARKS:

If well telescopes please sketch and show depths.

GROUND LEVEL

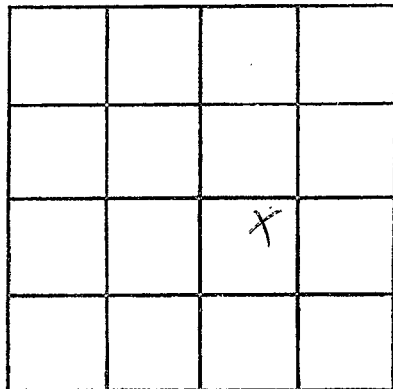

SECTION _____

Please indicate well location X.

ADDITIONAL INFORMATION

If more than one screen, show locations of each on sketch.

11/17/76