

PONTOTOC
C-74
7-16-71

MISSISSIPPI
 BOARD OF WATER COMMISSIONERS
 416 North State Street
 Jackson, Mississippi 39201

WATER WELL DRILLERS LOG

7-16 1971 Clark Bros Pontotoc
 date well completed firm name county well located

CODED

LANDOWNER:
Billy Shettes
Peru Route
 (mailing address)

description of formations encountered	from	to
<u>Red Clay</u>	<u>0</u>	<u>30</u>
<u>Red & Sand</u>	<u>30</u>	<u>60</u>
<u>Blue mud</u>	<u>60</u>	<u>180</u>
<u>Red & Sand</u>	<u>180</u>	<u>220</u>

WELL LOCATION:
 sec. 19 T. 8 S. R. 3 E.
5 1/2 miles NE of Peru
 (distance) (direction) (nearest town)

WELL PURPOSE: Domestic
 (home, irrigation, municipal, industrial)

- WELL COMPLETION DATA:
- (1) diameter (inches) 4 1/2"
 - (2) total depth (feet) 530'
 - (3) static water level (feet) 90' below above top of ground.
 - (4) casing metal, 8 1/2"
 (material) (depth)
4 if telescope see back.
 (size)
 - (5) screen mesh
 (length) (depth to top)
 (size) (material)
 - (6) pump 1 1/2 5
 (HP) (yield gpm)
Electric
 (type power)
 - (7) electric log no
 (yes or no)
 (organization running log)
 - (8) how well bottom plugged no

CODED


SEP 13 1971

MISS. RD. OF
 WATER COMM.

DRILLERS REMARKS:

If well telescopes please sketch and show depths.

GROUND LEVEL

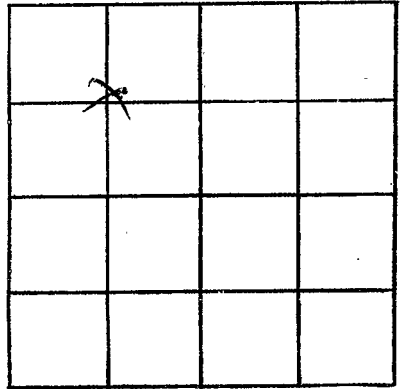

SECTION _____

Please indicate well location X.

ADDITIONAL INFORMATION

If more than one screen, show locations of each on sketch.