

**PONTOTOC**  
**C 77**  
**6-23-72**

MISSISSIPPI  
 BOARD OF WATER COMMISSIONERS  
 416 North State Street  
 Jackson, Mississippi 39201

WATER WELL DRILLERS LOG

6-23- 1972 Leeper Drilling & Pontotoc  
 date well completed firm name county well located

LANDOWNER:	description of formations encountered	from	to
<u>Calvin Young</u>	<u>Red clay &amp; sand</u>	<u>0</u>	<u>20</u>
<u>Pontotoc, Miss-</u>	<u>Rock &amp; Red Sand</u>	<u>20</u>	<u>60</u>
(mailing address)	<u>Blue Clay</u>	<u>60</u>	<u>90</u>
	<u>Blue clay &amp; Rock</u>	<u>90</u>	<u>120</u>
	<u>Rock &amp; Sand</u>	<u>120</u>	<u>190</u>

WELL LOCATION:  
 sec. 30 T 9 N R. 3 E  
2 miles NW of Pontotoc  
 (distance) (direction) (nearest town)

WELL PURPOSE: home  
 (home, irrigation, municipal, industrial)

WELL COMPLETION DATA:

(1) diameter (inches) 5"

(2) total depth (feet) 190

(3) static water level (feet) 60 below above top of ground.

(4) casing Steel, 94'  
 (material) (depth)  
 (size) If telescope see back.

(5) screen open  
 (length) (depth to top)  
 (size) (material)

(6) pump 3/4 10  
 (HP) (yield gpm)  
E. Leaf  
 (type power)

(7) electric log no  
 (yes or no)  
 (organization running log)

(8) how well bottom plugged open


DRILLERS REMARKS:

JUL 12 1972

MISSISSIPPI  
 BOARD OF WATER COMMISSIONERS

If well telescopes please sketch and show depths.

GROUND LEVEL

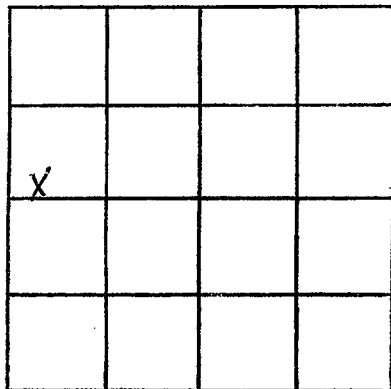

SECTION 30

Please indicate well location X.

ADDITIONAL INFORMATION

If more than one screen,  
show locations of each on sketch.