

PONTOTOC

C81

3-2-73

MISSISSIPPI
 BOARD OF WATER COMMISSIONERS
 416 North State Street
 Jackson, Mississippi 39201

WATER WELL DRILLERS LOG

CODED

3-2

1973

Laton Auter

Pontotoc

date well completed

firm name

county well located

LANDOWNER:

Dames Conway

description of formations encountered

Red Clay

from

to

0 30

Limestone

30 40

Blue Shale

40 85

Rock + Sand

85 190

Rt #2 - PONTOTOC

(mailing address)

WELL LOCATION:

sec. 7 T 9 N R 3 E E
 3 miles S of ECRU
 (distance) (direction) (nearest town)

WELL PURPOSE: HOME
 (home, irrigation, municipal, industrial)

WELL COMPLETION DATA: 3-2-73

- (1) diameter (inches) 4 1/2"
- (2) total depth (feet) 190
- (3) static water level (feet) 60 below top of ground.
- (4) casing Steel, 53 (material) (depth)
 4 (size) if telescope see back.
- (5) screen (length) (depth to top)
 (size) (material)
- (6) pump 1 (HP) 8 (yield gpm)
 Electric (type power)
- (7) electric log (yes or no)
- (8) how well bottom plugged


CODED

MAR 19 1973

DRILLERS REMARKS:

If well telescopes please sketch and show depths.

GROUND LEVEL

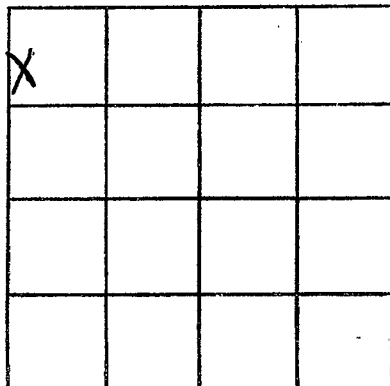

SECTION 7

Please indicate well location X.

ADDITIONAL INFORMATION

If more than one screen,
show locations of each on sketch.