

PONTOTOC

C82

3-9-73

3-9

date well completed

1973

MISSISSIPPI BOARD OF WATER COMMISSIONERS  
416 North State Street  
Jackson, Mississippi 39201

**CODED**

WATER WELL DRILLERS LOG

Laton Dutac  
firm name

Pontotoc  
county well located

LANDOWNER:

RANDY WARREN

R#2 PONTOTOC  
(mailing address)

description of formations encountered

Red Clay  
Brown Sand  
Blue Shale  
Rock + Sand

from

to

0 14  
14 20  
20 50  
50 185

WELL LOCATION:

sec 21 T 9 S R 3 E

4 miles N of PONTOTOC  
(distance) (direction) (nearest town)

WELL PURPOSE:

HOME  
(home, irrigation, municipal, industrial)

WELL COMPLETION DATA: 3-9-73

- (1) diameter (inches) 4
- (2) total depth (feet) 185
- (3) static water level (feet) 30 below top of ground.
- (4) casing Steel 42  
(material) (depth)
- 4 if telescope see back.  
(size)
- (5) screen Q  
(length) (depth to top)
- (size) (material)
- (6) pump 1 8  
(HP) (yield gpm)
- Electric  
(type power)
- (7) electric log no  
(yes or no)

(organization running log)

(8) how well bottom plugged

DRILLERS REMARKS:


**CODED**

MAR 10 1973

MISS. BD. OF WATER COMM.

If well telescopes please sketch and show depths.

GROUND LEVEL

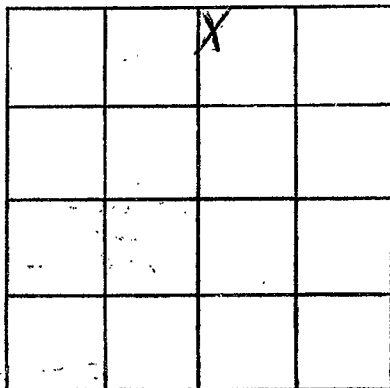

SECTION 21

Please indicate well location X.

ADDITIONAL INFORMATION

If more than one screen,  
show locations of each on sketch.