

PONTOTOC
 C84
 7-25-74

MISSISSIPPI
 BOARD OF WATER COMMISSIONERS
 416 North State Street
 Jackson, Mississippi 39201

CODED

WATER WELL DRILLERS LOG

7-25 1974 Bobby L. Swartz Pontotoc
 date well completed firm name county well located

LANDOWNER: Harvey
Abraham
Rt. 2 Pontotoc, Miss
 (mailing address)

description of formations encountered	from	to
<u>Red clay</u>	<u>0</u>	<u>20</u>
<u>peck</u>	<u>20</u>	<u>45</u>
<u>Blue mud</u>	<u>45</u>	<u>105</u>
<u>peck & sand</u>	<u>105</u>	<u>280</u>

WELL LOCATION
 sec. 19 T. 9 S. R. 3 E.
3 miles of PONTOTOC
 (distance) (direction) (nearest town)

WELL PURPOSE: Home
 (home, irrigation, municipal, industrial)


- WELL COMPLETION DATA:
- diameter (inches) 4"
 - total depth (feet) 250
 - static water level (feet) 20 below above top of ground.
 - casing Steel 78 ft
 (material) (depth)
4" If telescope see back.
 (size)
 - screen none
 (length) (depth to top)
 (size) (material)
 - pump 1 1/2 hp 2 stage 82 gpm
 (HP) (yield gpm)
Electric
 (type power)
 - electric log _____
 (yes or no)
 (organization running log)
 - how well bottom plugged _____

DRILLERS REMARKS:

RECEIVED
 AUG 21 1974

If well telescopes please sketch and show depths.

GROUND LEVEL

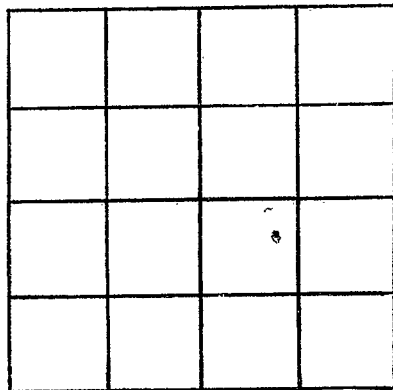

SECTION 19

Please indicate well location X.

ADDITIONAL INFORMATION

If more than one screen,
show locations of each on sketch.