

PONTOTOC
 C85
 12175
 Elec #45

MISSISSIPPI
 BOARD OF WATER COMMISSIONERS
 416 North State Street
 Jackson, Mississippi 39201

WATER WELL DRILLERS LOG CODED

December 1975 Herndon Well & Supply, Inc. Pontotoc
 date well completed firm name county well located

LANDOWNER:
 Oak Hill Water Association, Inc
 Pontotoc, MS
 (mailing address)

WELL LOCATION:
 sec 2 T 9 S R 3 E
 (distance) miles (direction) of (nearest town)

WELL PURPOSE: Community
 (home, irrigation, municipal, industrial)

WELL COMPLETION DATA:
 (1) diameter (inches) 8"
 (2) total depth (feet) 1170
 (3) static water level (feet) 375 below top of ground. XXXXX
 (4) casing Steel 1060 (material), (depth), 8" (size) If telescope see back.
 (5) screen 80' 1060 (length), (depth to top) .020 4" Stainless Steel (size), (material)
 (6) pump 50 200 (HP), (yield gpm)
 Elec. (type power)
 (7) electric log Yes (yes or no)
 USGS (organization running log)
 (8) how well bottom plugged 4 BW

description of formations encountered	from	to
Red Clay	0	15
Sand	15	30
Sand & Strkd Gumbo	30	90
Sand & Streaked Gumbo	90	105
Sand Rock	105	210
Blue Gumbo	210	750
Blue Gumbo & Strkd Sand	750	840
Blue Gumbo	840	1050
Streaked Sand & Gumbo	1050	1060
Sand	1060	1080
Blue Sand	1080	1110
Sand CODED	1110	1140
Gumbo	1140	1170

1060
 200
 1/4

12156
 12156
 12156

FEB 27 1976


DRILLERS REMARKS:

MISS. BD. OF WATER COMMISSIONERS

(X)

If well telescopes please sketch and show depths.

GROUND LEVEL

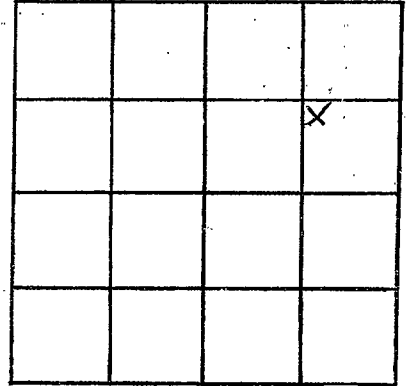

SECTION 21

Please indicate well location X.

ADDITIONAL INFORMATION

If more than one screen, show locations of each on sketch.