

Portotoc
C 86
7-15-75

MISSISSIPPI
 BOARD OF WATER COMMISSIONERS
 416 North State Street
 Jackson, Mississippi 39201

WATER WELL DRILLERS LOG

CODED

7-15 1975 Beh Smith Well Drilling Portotoc
 date well completed firm name county well located

LANDOWNER: <u>H. B. Garba</u>	description of formations encountered	from	to
<u>Memphis Tenn.</u> (mailing address)			
WELL LOCATION: sec. <u>17</u> T. <u>9</u> N. R. <u>30</u> 15F <u>3</u> miles <u>NW</u> of <u>Portotoc</u> (distance) (direction) (nearest town)	<u>red clay</u>	<u>0</u>	<u>20'</u>
	<u>sand & rock</u>	<u>20'</u>	<u>40'</u>
	<u>rock</u>	<u>40'</u>	<u>60'</u>
	<u>sand</u>	<u>60'</u>	<u>78'</u>
WELL PURPOSE: (home, irrigation, municipal, industrial)			
WELL COMPLETION DATA:			
(1) diameter (inches) <u>4</u>			
(2) total depth (feet) <u>78</u>			
(3) static water level (feet) <u>50</u> below top of ground.			
(4) casing <u>plastic</u> , <u>78</u> (material) (depth)			
(size) If telescope see back.			
(5) screen <u>10'</u> , <u>68'</u> (length) (depth to top)			
<u>4"</u> , <u>plastic</u> (size) (material)			
(6) pump <u>1/3</u> , <u>10</u> (HP) (yield gpm)			
<u>electric</u> (type power)			
(7) electric log <u>no</u> (yes or no)			
(organization running log)			
(8) how well bottom plugged <u>plugged</u>			
DRILLERS REMARKS:			

CODED


DRILLERS LOG

AUG 1 1975

MISS. BD. OF WATER COMMISSIONERS

If well telescopes please sketch and show depths.

GROUND LEVEL

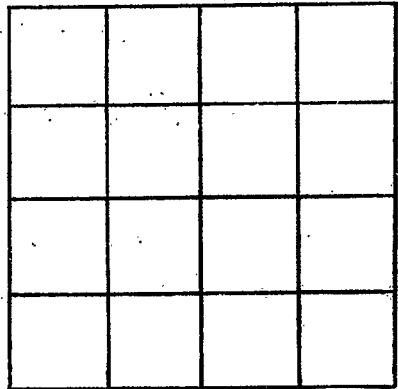

SECTION _____

Please indicate well location X.

ADDITIONAL INFORMATION

If more than one screen, show locations of each on sketch.