

Pontotoc  
C 87  
7-7-75

MISSISSIPPI  
 BOARD OF WATER COMMISSIONERS  
 416 North State Street  
 Jackson, Mississippi 39201

CODED

WATER WELL DRILLERS LOG

7-7-75 1975 Bobby L. Sewards Pontotoc  
 date well completed firm name county well located

LANDOWNER: Larry Russell  
Pontotoc, Miss.  
 (mailing address)

description of formations encountered	from	to
<u>Red Sand</u>	<u>0</u>	<u>20</u>
<u>Rock</u>	<u>20</u>	<u>40</u>
<u>Blue mud</u>	<u>40</u>	<u>140</u>
<u>Rock + Sand</u>	<u>140</u>	<u>200</u>

WELL LOCATION:  
 sec. 30 T. 9 N. R. 30 E. 15F  
1 miles North of Pontotoc  
 (distance) (direction) (nearest town)

WELL PURPOSE: Home  
 (home, irrigation, municipal, industrial)

- WELL COMPLETION DATA:
- (1) diameter (inches) 4"
  - (2) total depth (feet) 200
  - (3) static water level (feet) 20 below above top of ground.
  - (4) casing Steel 84 ft.  
 (material) (depth)  
4" if telescope see back.  
 (size)
  - (5) screen None  
 (length) (depth to top)  
 (size) (material)
  - (6) pump 1 HP 2 stage 89 gpm  
 (HP) (yield gpm)  
Electric  
 (type power)
  - (7) electric log \_\_\_\_\_  
 (yes or no)  
 (organization running log)
  - (8) how well bottom plugged \_\_\_\_\_

CODED


DRILLERS REMARKS:

MISSISSIPPI BOARD OF WATER COMMISSIONERS  
 AUG 7 1975

MISS. BD. OF WATER COMMISSIONERS

If well telescopes please sketch and show depths.

GROUND LEVEL

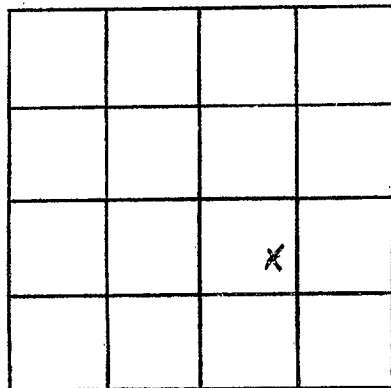

SECTION 30

Please indicate well location X.

ADDITIONAL INFORMATION

If more than one screen,  
show locations of each on sketch.