

Pontotoc  
 C 89  
 11/80  
 NOV

MISSISSIPPI  
 BOARD OF WATER COMMISSIONERS  
 416 North State Street  
 Jackson, Mississippi 39201

CODED

WATER WELL DRILLERS LOG

date well completed

firm name

county well located

1980 LEEPER Drilling Pontotoc

LANDOWNER:

Wilton Castings Corp  
 Pontotoc MS  
 (mailing address)

description of formations encountered

from to

TOP CLAY	0	30
RED SAND	30	60
BLUE CLAY	60	90
SAND	90	150
BLUE CLAY	150	200
CHALK	200	300
SAND	300	320
CHALK	320	360
SAND	360	390
CHALK	390	1140
SAND + GRAVEL	1140	1220

WELL LOCATION:

29 sec 32 T 9 N R 30 E  
 Pontotoc  
 miles of (distance) (direction) (nearest town)

WELL PURPOSE: Industrial  
 (home, irrigation, municipal, industrial)


WELL COMPLETION DATA:

- (1) diameter (inches) 4
- (2) total depth (feet) 1220
- (3) static water level (feet) 215 below above top of ground.
- (4) casing (material) (depth) 4x2 If telescope see back.
- (5) screen 80' 1140 (length) (depth to top)  
2" Steel (size) (material)
- (6) pump 7 1/2 50 (HP) (yield gpm)  
3 hp (type power)
- (7) electric log yes (yes or no)  
STATE Geological (organization running log)
- (8) how well bottom plugged CAP

DEPT. OF NATURAL RESOURCES  
 BUREAU OF LAND & WATER RESOURCES

FEB 24 1981


RECEIVED

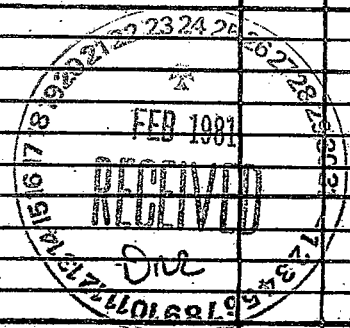

DRILLERS REMARKS:

If well telescopes please sketch and show depths.

GROUND LEVEL

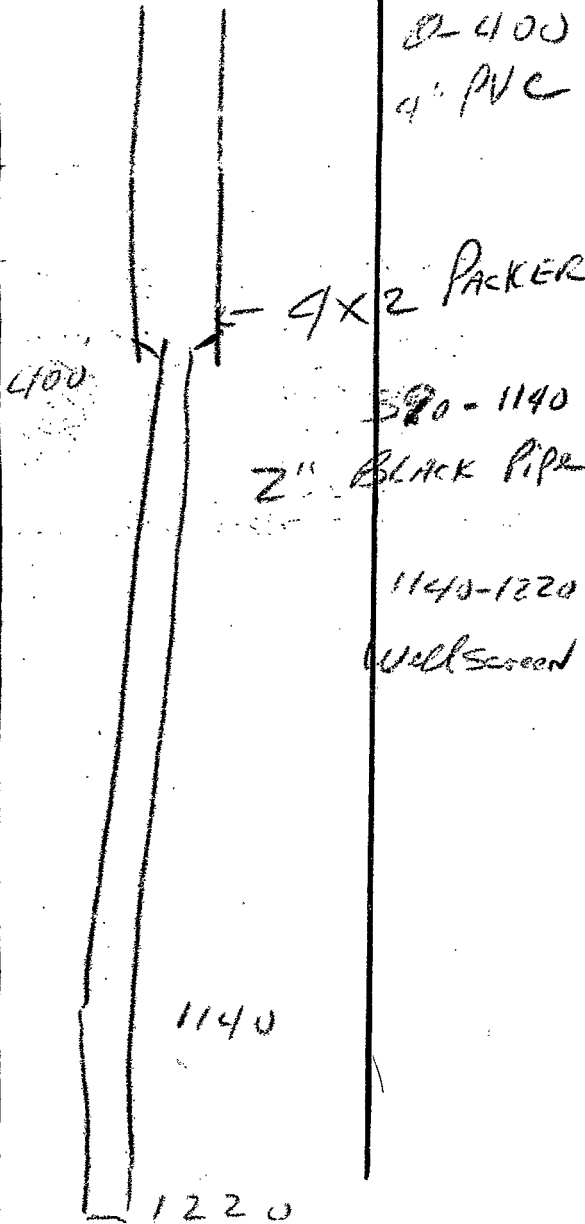


SECTION \_\_\_\_\_

Please indicate well location X.

ADDITIONAL INFORMATION

4" PVC  
 CASING is  
 grouted and  
 2" is connected  
 to 4" by 4x2  
 K-TYPE PACKER

If more than one screen, show locations of each on sketch.