

MISSISSIPPI DEPARTMENT OF NATURAL RESOURCES

Bureau of Land and Water Resources

Southport Mall

P.O. Box 10631

CODED

Jackson, Mississippi 39209

WATER WELL DRILLERS LOG

Pontotoc
C 92

3-10-87 T.M.M Panks Drilling Co. Pontotoc
 date well completed firm name county well located

LANDOWNER: East Pontotoc
 Water Assoc., Inc.
 Rt. 3 Box 315
 Pontotoc, Ms. 38863
 (mailing address)

WELL LOCATION:
 sec. 35 T-9 N R-3 E
 S W
East of Pontotoc
 (distance) miles (direction) of (nearest town)

WELL PURPOSE: City
 (home, irrigation, municipal, industrial)

WELL COMPLETION DATA:
 (1) diameter (inches) 14"
 (2) total depth (feet) 1120"
 (3) static water level (feet) 359" 8 below above top of ground.
 (4) casing US. Steel 901'
 (material) (depth)
10 3/4" if telescope see back.
 (size)
 (5) screen 80' 910'
 (length) (depth to top)
6" Stainless
 (size) (material)
 (6) pump 60 300
 (HP) (yield gpm)
30
 (type power)
 (7) electric log Yes
 (yes or no)
MGS
 (organization running log)
 (8) how well bottom plugged BPV

description of formations encountered	from to	
	from	to
Top Soil	0	40
Sand & Shale	40	150
Rock, Sand Soil	150	190
Sandy Chalk	190	210
Limestone / Shale	210	870
Fine Sand	870	885
Hard Limestone	885	905
Sand & Shale	905	1120

CODED

RECEIVED


AUG 03 1987

Department of Natural Resources
 Bureau of Land & Water Resources

DRILLERS REMARKS:

If well telescopes please
sketch and show depths.

GROUND LEVEL

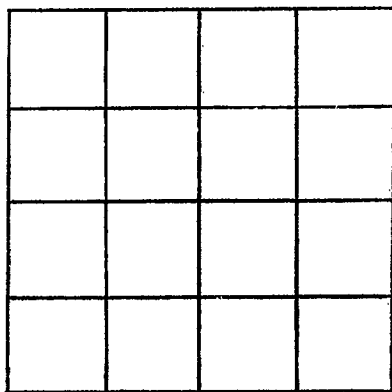

SECTION _____

Please indicate well location X.

ADDITIONAL INFORMATION

If more than one screen,
show locations of each on sketch.