


If well telescopes please sketch and show depths.

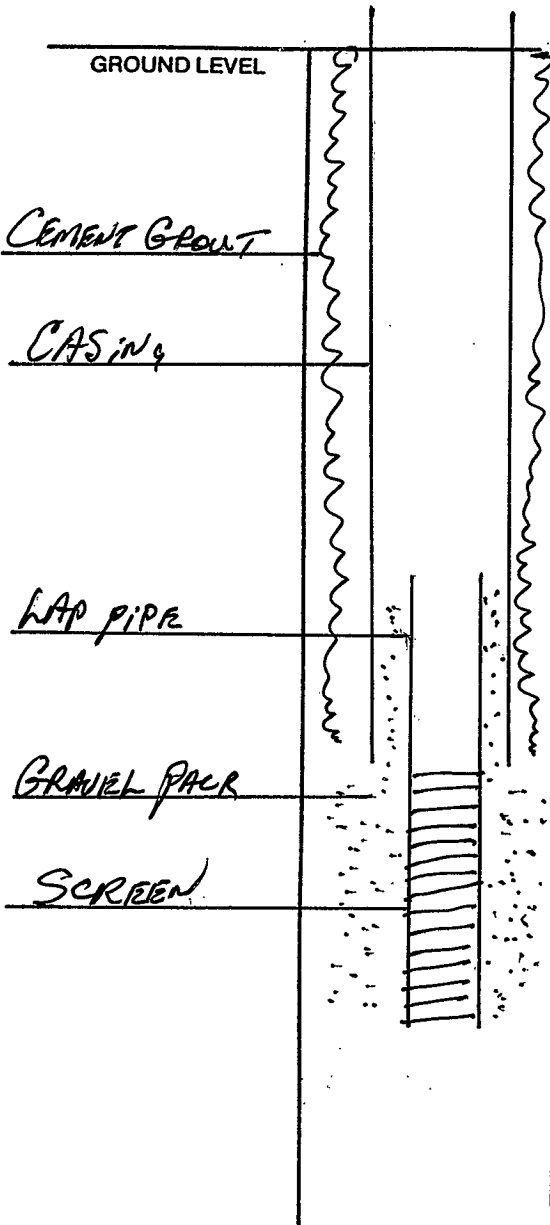

SECTION _____

Please indicate well location X.

Pump Capacity (GPM)	No. of Stages	Setting Depth
250	16	462 FT.
PUMP TEST		
Well yielded <u>287</u> GPM with		
a drawdown of <u>67.9</u> ft.		
after <u>2</u> hours of pumping		

LOG DATA

TYPE OF LOG RUN (Circle One):	No Log Run.
<input checked="" type="radio"/> Electric, <input type="radio"/> Gamma Ray, <input type="radio"/> Density, <input type="radio"/> Sonic, <input type="radio"/> Neutron,	
Other (Describe) _____	
Name of Organization Running Log	
MSGs	

GEOLOGIC DATA (Office Use Only)

Surface Elev.	Geologic Unit	Unit Thickness	Depth to Top
Subs. SWL	Date	Analysis	Aquifer Test

Driller's Remarks

If more than one screen, show location of each on sketch.