

Pontotoc  
C 2000  
8/4/76

MISSISSIPPI  
 BOARD OF WATER COMMISSIONERS  
 416 North State Street  
 15F Jackson, Mississippi 39201

WATER WELL DRILLERS LOG

8/4/76 date well completed      19 MEDLIN WELL DRG. Co. Pontotoc firm name      Pontotoc county well located

LANDOWNER: LEO REED  
ECRY MISS

description of formations encountered	from	to
<u>CLAY</u>	<u>0</u>	<u>20</u>
<u>CLAY &amp; Rock</u>	<u>20</u>	<u>70</u>
<u>Rock &amp; SAND</u>	<u>70</u>	<u>110</u>

(mailing address)

1 mi E  
ECRY

WELL LOCATION:  
 sec. 28 T 8 N R. 3 E  
7 miles NORTH of Pontotoc  
 (distance) (direction) (nearest town)

WELL PURPOSE: HOME  
 (home, irrigation, municipal, industrial)

- WELL COMPLETION DATA:
- (1) diameter (inches) 4
  - (2) total depth (feet) 110 FT.
  - (3) static water level (feet) 40 <sup>below</sup> above top of ground.
  - (4) casing Plastic 110 FT  
 (material) (depth)
  - (size) If telescope see back.
  - (5) screen 10 FT. 100 FT.  
 (length) (depth to top)
  - 4" Plastic  
 (size) (material)
  - (6) pump 1/2 12  
 (HP) (yield gpm)
  - (type power)
  - (7) electric log (yes or no)
  - (organization running log)
  - (8) how well bottom plugged QAP.  
P.V.C.

**RECEIVED**


DEC 2 1976

DRILLERS REMARKS:

MISS. COMM.

If well telescopes please sketch and show depths.

GROUND LEVEL

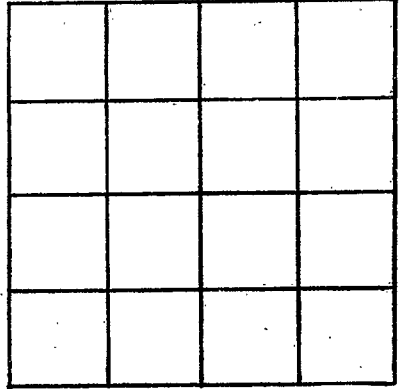

SECTION \_\_\_\_\_

Please indicate well location X.

ADDITIONAL INFORMATION

If more than one screen, show locations of each on sketch.