

PONTOTOC

C

2001

10-15-77

MISSISSIPPI BOARD OF WATER COMMISSIONERS  
416 North State Street  
Jackson, Mississippi 39201

WATER WELL DRILLERS LOG

10-15 1977  
date well completed

Leper  
firm name

Pontotoc  
county well located

LANDOWNER:	description of formations encountered	from	to
Steve Stubblefield Rt. 7 Pontotoc (mailing address)	white clay red sand & rock blue clay sand	0 15' 65' 160'	15' 65' 160' 200'
<b>WELL LOCATION:</b>			
sec. 9 T 9 N R 3 E S W Corn 5 miles SE of Pontotoc (distance) (direction) (nearest town)			
<b>WELL PURPOSE:</b> Home (home, irrigation, municipal, industrial)			
<b>WELL COMPLETION DATA:</b>			
(1) diameter (inches) 4			
(2) total depth (feet) 200'			
(3) static water level (feet) 80 (below/above top of ground)			
(4) casing Steel 84' (material) (depth) if telescope see back. (size)			
(5) screen (length) (depth to top) (size) (material)			
(6) pump 3/4 10 (HP) (yield gpm) Elec (type power)			
(7) electric log No (yes or no)			
(organization running log)			
(8) how well bottom plugged open			
<b>DRILLERS REMARKS:</b>			


RECEIVED

APR 24 1978

MISS. BD. OF WATER COMMISSIONERS

If well telescopes please sketch and show depths.

GROUND LEVEL

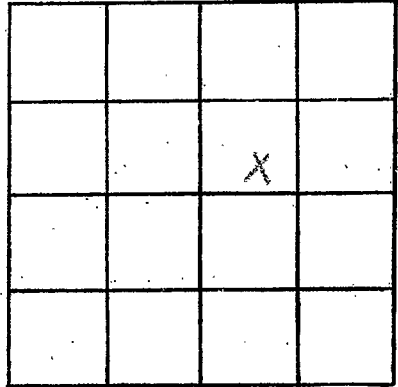

SECTION 9

Please indicate well location X.

ADDITIONAL INFORMATION

If more than one screen,  
show locations of each on sketch.