

PONTOTOC

C  
2008

1-16-78

MISSISSIPPI  
BOARD OF WATER COMMISSIONERS  
416 North State Street  
Jackson, Mississippi 39201

WATER WELL DRILLERS LOG

1-16

1978

Leper

Pontotoc

date well completed

firm name

county well located

LANDOWNER:

Patricia Dykes  
Rt. 4 Pontotoc, Ms.  
(mailing address)

description of formations encountered

from

to

Red clay	0	20'
Red sand & clay	20	60'
Blue clay + roll	60	140'
Chalk + rock	140'	200'
Sand	200	260

WELL LOCATION:

sec. 3 T. 9 N. R. 3 E.  
S W ECRH  
2 miles S F of Pontotoc  
(distance) (direction) (nearest town)

WELL PURPOSE: Home  
(home, irrigation, municipal, industrial)

WELL COMPLETION DATA:

- (1) diameter (inches) 4
- (2) total depth (feet) 260'
- (3) static water level (feet) 80 <sup>below</sup> <sub>above</sub> top of ground.
- (4) casing Steel, 84',  
(material) (depth)  
(size) if telescope see back.
- (5) screen (length) (depth to top)  
(size) (material)
- (6) pump 1/2 HP, 5  
(HP) (yield gpm)  
Elec.  
(type power)
- (7) electric log No  
(yes or no)

(organization running log)

(8) how well bottom plugged open


DRILLERS REMARKS:

RECEIVED  
APR 27 1978

MISS. Bd. OF WATER COMMISSIONERS

If well telescopes please sketch and show depths.

GROUND LEVEL

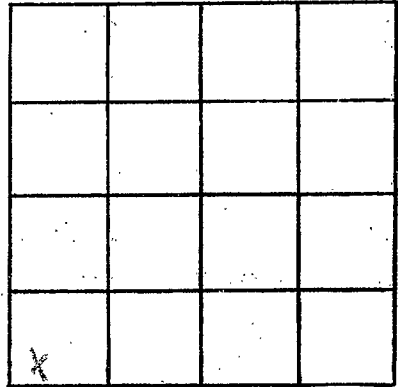

SECTION 3

Please indicate well location X.

ADDITIONAL INFORMATION

If more than one screen, show locations of each on sketch.