

PONTOTOC
 C2004
 3/17/78

MISSISSIPPI
 BOARD OF WATER COMMISSIONERS
 416 North State Street
 Jackson, Mississippi 39201

WATER WELL DRILLERS LOG

Herman Homan Well & Supply, Inc.
 P. O. Box 42

March 17 1978
 date well completed

SHANNON, MISSISSIPPI 38668

Pontotoc
 county well located

LANDOWNER:
 Charles Hesterias
 Pontotoc, MS.
 (mailing address)

description of formations encountered	from	to
surface sand	0	28
clay	28	40
clay	40	160
bottom	160	

WELL LOCATION:
 sec. 18 T. 9 N. R. 3 E.
 2 1/2 miles S of ECRU
 (distance) (direction) (nearest town)

WELL PURPOSE: Home
 (home, irrigation, municipal, industrial)

- WELL COMPLETION DATA:
- diameter (inches) 4 9
 - total depth (feet) 160
 - static water level (feet) 50 below top of ground.
 - casing steel 3 1/2" (material) (depth)
 4" (size) if telescope see back.
 - screen no (length) (depth to top)
 - pump 1/2 (HP) 5 (yield gpm)
 electric (type power)
 - electric log no (yes or no)

(organization running log)
 (8) how well bottom plugged open

DRILLERS REMARKS:


RECEIVED

MAR 23 1978

MISS. BD. OF WATER COMMISSIONERS

If well telescopes please sketch and show depths.

GROUND LEVEL

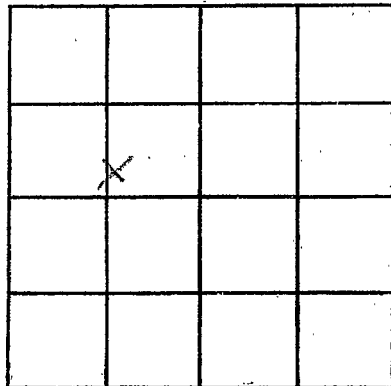

SECTION 18

Please indicate well location X.

ADDITIONAL INFORMATION

If more than one screen,
show locations of each on sketch.