

PONTOTOC
D 17
5-21-72

MISSISSIPPI
BOARD OF WATER COMMISSIONERS
416 North State Street
Jackson, Mississippi 39201

WATER WELL DRILLERS LOG **CODED**

May 21 1972 J.W. Webb & Sons Pontotoc
date well completed firm name county well located

LANDOWNER: <u>Jimmy Crauch</u>	description of formations encountered	from	to
<u>Belden Miss</u> (mailing address)	Soil	0	1
WELL LOCATION:	Bumho	1	34
sec. <u>11</u> T. <u>9</u> N. R. <u>4</u> E <u>1 1/2</u> miles <u>East</u> of <u>Endville</u> (distance) (direction) (nearest town)	Blue Rock	34	311
WELL PURPOSE: (home, irrigation, municipal, industrial)	Water Rock	311	312
WELL COMPLETION DATA:	Water Sand	312	445
(1) diameter (inches) <u>5"</u>	<u>Coffee sand</u>		
(2) total depth (feet) <u>445</u>	445		
(3) static water level (feet) <u>161</u> below above top of ground.	312		
(4) casing <u>steel, 38H</u> (material) (depth) <u>5'</u> (size) If telescope see back.	133		
(5) screen <u>0</u> <u>0</u> (length) (depth to top)	CODED		
(6) pump <u>0</u> <u>0</u> (size) (material)			
(6) pump <u>No pump</u> (HP) (yield gpm)			
(type power)			
(7) electric log (yes or no)			
(organization running log)			
(8) how well bottom plugged			
DRILLERS REMARKS:			


CODED

JUN 13 1972

MISS. BD. OF
WATER COMM.

If well telescopes please sketch and show depths.

GROUND LEVEL

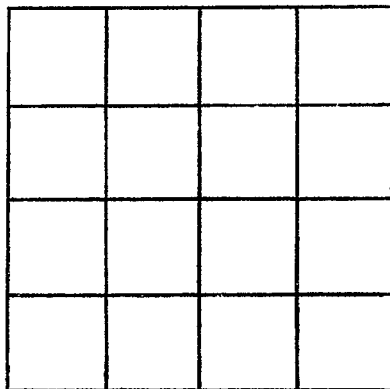

SECTION _____

Please indicate well location X.

ADDITIONAL INFORMATION

If more than one screen,
show locations of each on sketch.