

~~LEE~~
~~6~~

Coded

7-27-62 DZ WATER WELL DRILLERS LOG

Date: 7-27, 1962, Driller: Q. C. Welch County Lee

800111110

(1) Owner of Land: James Coakern
(Name)
Belden
(Address)

(2) Location: 11 SE 1/4, 1/4, Sec. 12 T9 R4
3 1/2 miles West, of Belden
(distance) (direction) (Nearest Town)

(3) Topography: K
(Hilly) (Flat) (Level)

(4) Purpose of Well: /
(Domestic Irrigation
Municipal, Industrial, Other)

Description & Color of Materials Sand, Clay, Red Clay, Shell, etc.	Thick- ness Feet	Depth Feet.
<u>Soil to 11 ft white</u>		
<u>Rock to 2.5 ft</u>		
<u>Blue marl to</u>		
<u>288 ft water</u>		
<u>Rock 18 in water</u>		
<u>Sand to 3.60 ft</u>		

Information upon completion of well:

(1) Diameter 4 inches.


(2) Total Depth 360 feet.

(3) Water Level 130 feet below top of ground.

(4) Cased to 30 ft, Size 4"

(5) Screen: Size _____, Length _____

(6) Were any formations sealed against pollution?
_____ yes, _____ no.

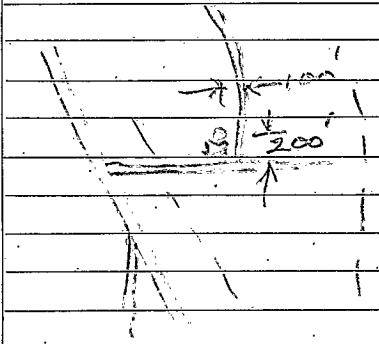


If YES depth of formation _____

Why _____

Drillers Remarks: rod pump

Hand to man WL

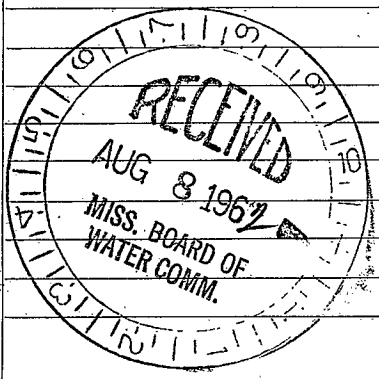

108 ELEV 410

(Use Back Side)

Well No.

1914

1915

1916

1917

1918

1919