

13C

MISSISSIPPI
BOARD OF WATER COMMISSIONERS
416 North State Street
Jackson, Mississippi 39201

CODED

WATER WELL DRILLERS LOG

Pontotoc
D 23
11-2-68

Nov. 2 1968 J. W. Welch Pontotoc
date well completed firm name county well located

LANDOWNER:	description of formations encountered	from	to
Mr. Royce Powell			
Erin. Rt. 1. (mailing address)	Blue marl	15	350
WELL LOCATION:	Water sand & Blue marl	350	380
sec. 9 T. 9 S. R. 4 E	Water sand	380	500
5 miles West of Belser (distance) (direction) (nearest town)			
WELL PURPOSE: home (home, irrigation, municipal, industrial)			
WELL COMPLETION DATA:			
(1) diameter (inches) 5"			
(2) total depth (feet) 500			
(3) static water level (feet) 120 below top of ground.			
(4) casing steel 21' (material) (depth)			
(size) If telescope see back.			
(5) screen none (length) (depth to top)			
(size) (material)			
(6) pump 1/2 7 (HP) (yield gpm)			
electric (type power)			
(7) electric log no (yes or no)			
(organization running log)			
(8) how well bottom plugged			
DRILLERS REMARKS:			


CODED

REC 9 1001
3968 1001

MISSISSIPPI
BOARD OF WATER COMMISSIONERS

If well telescopes please
sketch and show depths.

GROUND LEVEL

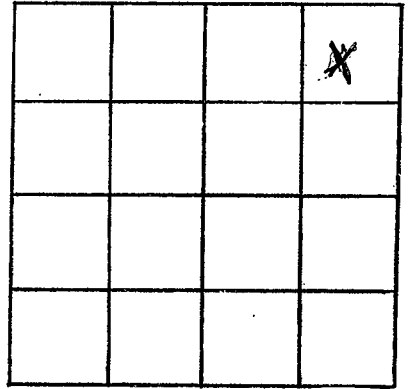

SECTION 9

Please indicate well location X.

ADDITIONAL INFORMATION

If more than one screen,
show locations of each on sketch.