

EAST SITE

MISSISSIPPI
 BOARD OF WATER COMMISSIONERS CODED
 416 North State Street
 Jackson, Mississippi 39201

WATER WELL DRILLERS LOG

Pontotoc
D24
4-69
U.S.G.S.
4

1969 Herndon-Homan Well Supply Pontotoc Co.
 date well completed firm name county well located

LANDOWNER: East Pontotoc
Water Assoc.
Pontotoc Co, Miss.
 (mailing address)

WELL LOCATION:
 sec 26 T 9 S R 4 E
2 miles North of Furn
 (distance) (direction) (nearest town)

WELL PURPOSE: Community
 (home, irrigation, municipal, industrial)

WELL COMPLETION DATA:

(1) diameter (inches) 8"

(2) total depth (feet) 917'

(3) static water level (feet) 203' below top of ground.

(4) casing Steel 700'
 (material) (depth)
8" if telescope see back.
 (size)

(5) screen 80' 4"
 (length) (depth to top)
4" 620'
 (size) (material)

(6) pump 30 200
 (HP) (yield gpm)

electric
 (type power)

(7) electric log yes
 (yes or no)
U.S.G.S.
 (organization running log)

(8) how well bottom plugged g/w

description of formations encountered	from	to
Red Clay	0	8
lime rock	8	30
Blue sand fine	30	42
Rock	42	43
Blue Rock	43	345
Sand	345	435
Rock	435	436
Sand	436	500
lime rock to shale	500	590
Sand	590	815
Shale	815	875
Shale	875	915
limbo	915	917

CODED

MAY 27 1969

DRILLERS REMARKS:

PROG. PD OF
 WATER COMM.

(4)

If well telescopes please sketch and show depths.


GROUND LEVEL

700' casing
8"

4" Bottom

63' Drank
20' Sivered
21' Black
20' Sivered
20' Black
20' Sivered
21' Black

734
-744
-765
-785
847'
Bottom
undrilled
hole

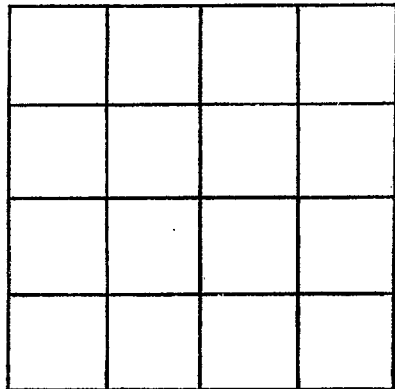

SECTION 26

Please indicate well location X.

ADDITIONAL INFORMATION

Lined area for additional information.

If more than one screen, show locations of each on sketch.