

MISSISSIPPI
BOARD OF WATER COMMISSIONERS
416 North State Street
Jackson, Mississippi 39201

WATER WELL DRILLERS LOG

Pontotoc
D28
7-69

July 19 69 J.W. Webb & Sons Pontotoc
date well completed firm name county well located

LANDOWNER: Otha Morrison

description of formations encountered from to

Belden Miss
(mailing address)

Soil 0 11
white Rock 11 28
Blue Rock 28 291
Water Rock 281 292
Water Sand coffee 292 400

WELL LOCATION:
sec. 13 T 9 S N R 4 E
S W
3 miles west of Belden
(distance) (direction) (nearest town)

WELL PURPOSE:
(home, irrigation, municipal, industrial)

WELL COMPLETION DATA:


- (1) diameter (inches) 5
- (2) total depth (feet) 400
- (3) static water level (feet) 177 below above top of ground.
- (4) casing steel 42 ft
(material) (depth)
5 (size) if telescope see back.
- (5) screen 0 (length) 0 (depth to top)
(size) (material)
- (6) pump 1/2 HP 6 (yield gpm)
Galva (type power)
- (7) electric log no (yes or no)
(organization running log)
- (8) how well bottom plugged

DRILLERS REMARKS:

SEP 22 1969
MISC. BD. OF
WATER COMMISSIONERS

If well telescopes please sketch and show depths.

GROUND LEVEL

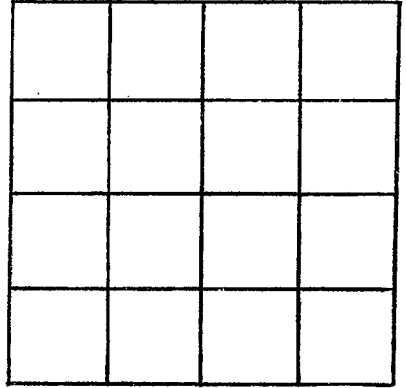

SECTION 13

Please indicate well location X.

ADDITIONAL INFORMATION

If more than one screen, show locations of each on sketch.