

MISSISSIPPI
BOARD OF WATER COMMISSIONERS
416 North State Street
Jackson, Mississippi 39201

WATER WELL DRILLERS LOG

Pontotoc
D29,
8-69


Aug 1969 J.W. Webb & Sons Pontotoc
date well completed firm name county well located

LANDOWNER:	description of formations encountered	from	to
<i>Sterling Nodge</i>			
<i>Belden, Miss</i> (mailing address)	<i>Soil</i>	<i>0</i>	<i>16</i>
	<i>Blue Rock</i>	<i>16</i>	<i>290</i>
	<i>Water sand</i>	<i>290</i>	<i>400</i>
	<i>Clay</i>		
WELL LOCATION: sec. <i>14</i> T <i>9</i> S N R <i>4</i> E S W <i>1</i> miles <i>North</i> of <i>Chestnut</i> (distance) (direction) (nearest town)			
WELL PURPOSE: (home, irrigation, municipal, industrial)			
WELL COMPLETION DATA: (1) diameter (inches) <i>5</i> (2) total depth (feet) <i>400</i> (3) static water level (feet) <i>165</i> below above ground (4) casing <i>Steel</i> , <i>28</i> , (material) (depth) <i>5</i> (size) if telescope see back. (5) screen _____ (length) (depth to top) (size) (material) (6) pump <i>1/2</i> <i>6</i> (HP) (yield gpm) <i>Electric</i> (type power) (7) electric log _____ (yes or no) (organization running log) (8) how well bottom plugged _____			
DRILLERS REMARKS:			

SEP 29 1969
MISS. DEPT. OF
WATER CONTROL

If well telescopes please sketch and show depths.

GROUND LEVEL

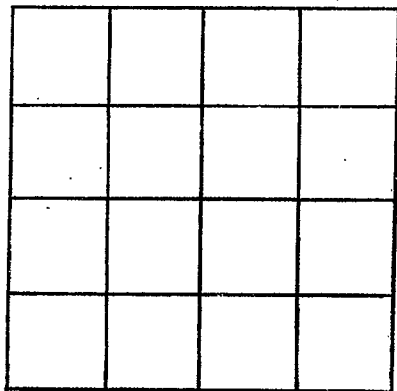

SECTION 14

Please indicate well location X.

ADDITIONAL INFORMATION

If more than one screen,
show locations of each on sketch.