

CODED

MISSISSIPPI
BOARD OF WATER COMMISSIONERS
416 North State Street
Jackson, Mississippi 39201

WATER WELL DRILLERS LOG

Pontotoc
D 30
8-69

Aug 19 69 J.W. Welberson Pontotoc
date well completed firm name county well located


LANDOWNER: J.P. McFarney	description of formations encountered	from	to
	Soil	0	14
Belders (mailing address)	Clay	14	28
	Blue Rock	28	7.98
WELL LOCATION: sec. 14 T 9 S N R 4 E S W	Water sand	29.8	4.10
1 1/4 miles north of Chester	Blue Rock	4.10	4.20
(distance) (direction) (nearest town)	Coffee		
WELL PURPOSE: (home, irrigation, municipal, industrial)			
WELL COMPLETION DATA:			
(1) diameter (inches) 5			
(2) total depth (feet) 42.0			
(3) static water level (feet) 16.9 below top of ground.			
(4) casing Steel 33 1/4" (material) (depth)			
(size) if telescope see back.			
(5) screen (length) (depth to top)			
(size) (material)			
(6) pump 1/2 (HP) 6 (yield gpm)			
Elec (type power)			
(7) electric log (yes or no)			
(organization running log)			
(8) how well bottom plugged			
DRILLERS REMARKS:			

SEP 22 1969

MISS. RI. CE
WATER CURE

If well telescopes please sketch and show depths.

GROUND LEVEL

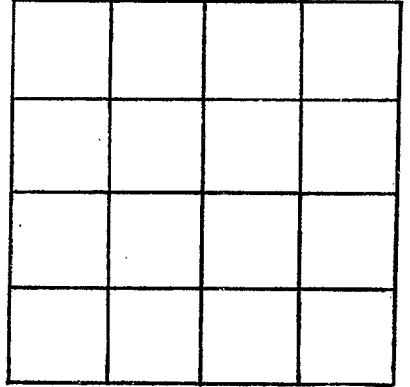

SECTION 14

Please indicate well location X.

ADDITIONAL INFORMATION

If more than one screen,
show locations of each on sketch.