

Pontotoc
D31
8-69

MISSISSIPPI
BOARD OF WATER COMMISSIONERS
416 North State Street
Jackson, Mississippi 39201

WATER WELL DRILLERS LOG

Aug 1969 date well completed
J. W. Webbers firm name
Pontotoc county well located

LANDOWNER: Joe Montgomery

description of formations encountered	from	to
soil	0	17
Blue Rock	17	304
Water Sand	304	410
Coal		

Belden, Miss
(mailing address)

WELL LOCATION:
sec. 14 T 9 S N R 4 E
1 1/2 miles north of Chestnut
(distance) (direction) (nearest town)

WELL PURPOSE:
(home, irrigation, municipal, industrial)

WELL COMPLETION DATA:

- (1) diameter (inches) 5
- (2) total depth (feet) 420
- (3) static water level (feet) 176 below top of ground.
- (4) casing Steel 22 (material) (depth)
- (size) if telescope see back.
- (5) screen (length) (depth to top)
- (size) (material)
- (6) pump 1/2 HP 6 (yield gpm)
- Elec (type power)
- (7) electric log (yes or no)
- (organization running log)
- (8) how well bottom plugged


SEP 29 1969

MISS. STATE WATER CONTROL

DRILLERS REMARKS:

If well telescopes please sketch and show depths.

GROUND LEVEL

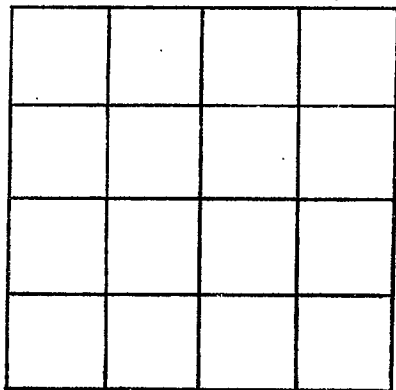

SECTION 14

Please indicate well location X.

ADDITIONAL INFORMATION

Lined area for additional information.

If more than one screen, show locations of each on sketch.