

CODED

MISSISSIPPI
BOARD OF WATER COMMISSIONERS
416 North State Street
Jackson, Mississippi 39201

WATER WELL DRILLERS LOG

Pontotoc
D 32
8-69

Aug 19 69 J. W. Webbsons Pontotoc
date well completed firm name county well located

LANDOWNER: Fat Wilson

description of formations encountered

from

to

Belden Miss.
(mailing address)

Soil 0 15
Blue Rock 15 301
Water sand 301 410
coffee

WELL LOCATION:

sec. 14 T 95 N R 4 E
S W
1 1/2 miles north of Chesterville
(distance) (direction) (nearest town)

WELL PURPOSE:

(home, irrigation, municipal, industrial)

WELL COMPLETION DATA:

- (1) diameter (inches) 5
- (2) total depth (feet) 410
- (3) static water level (feet) 172 below above top of ground.
- (4) casing steel, 22 (material) (depth);
_____ if telescope see back.
(size)
- (5) screen _____ (length) _____ (depth to top)
(size) (material)
- (6) pump 1/2 HP 6 (HP) (yield gpm)
Elec. (type power)
- (7) electric log _____ (yes or no)
_____ (organization running log)
- (8) how well bottom plugged _____


SEP 22 1969

MISS. BOARD OF WATER COMMISSIONERS

DRILLERS REMARKS:

If well telescopes please sketch and show depths.

GROUND LEVEL

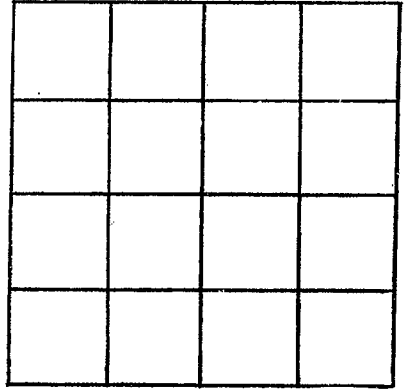

SECTION 14

Please indicate well location X.

ADDITIONAL INFORMATION

If more than one screen,
show locations of each on sketch.