

PONTIAC
D 40

Date: 3/2, 1962

Driller: James Fowler County: Stone
(Name)

CODED

(1) Owner of Land: William Mc Brown
 (Name)
Sherman
 (Address)
 9/3/69
 OK

(2) Location: $\frac{1}{4}$, $\frac{1}{4}$, Sec. 35 T85R4E
 _____ miles _____ of Sherman
 (distance) (direction) (Nearest Town)

(3) Topography: level
 (Hilly) (Flat) (Level)

(4) Purpose of Well: Domestic
 (Domestic Irrigation
 Municipal, Industrial, Other)

Description & Color of Materials Sand, Clay, Red Clay, Shell, etc.	Thick- ness Feet	Depth Feet
<u>yellow clay</u>	<u>22'</u>	
<u>Blue rock</u>		
<u>sand</u>		

Information upon completion of well:

(1) Diameter 4 inches.

(2) Total Depth 365' feet.

(3) Water Level 80" feet below top of ground.

(4) Cased to 26', Size 4.

(5) Screen: Size _____, Length _____.


(6) Were any formations sealed against pollution?
 yes, _____ no.

If YES depth of formation _____

Why _____

Drillers Remarks: _____

CODED

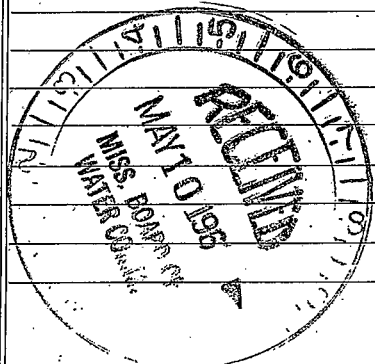

(Use Back Side)

Well No.

[The page contains extremely faint and illegible text, likely bleed-through from the reverse side of the document. The text is scattered across the page and cannot be transcribed accurately.]